


1 LOCATION OF WATER WELL: County: Republic Fraction 1/4 1/4 SE 1/4 Section Number 2 Township Number T 3 S Range Number 3 EW

Distance and direction from nearest town or city street address of well if located within city? 55' West of center of North Street, 178' South of center of 17th Street, Belleville

2 WATER WELL OWNER: Double Circle Farm Supply 1819 L Street Belleville, Ks. Board of Agriculture, Division of Water Resources Application Number:

3 LOCATE WELL'S LOCATION WITH AN "X" IN SECTION BOX:

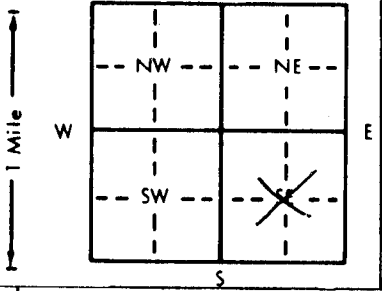

4 DEPTH OF COMPLETED WELL: 20 ft. ELEVATION: NA

WELL'S STATIC WATER LEVEL: NA ft. below land surface measured on mo/day/yr. Pump test data: Well water was NA ft. after NA hours pumping NA gpm. Est. Yield: NA gpm. Bore Hole Diameter: 8 in. to 20 in. WELL WATER TO BE USED AS: 10 Monitoring well. Was a chemical/bacteriological sample submitted to Department? No. X

5 TYPE OF BLANK CASING USED: 2 PVC, 3 RMP (SR), 5 Wrought iron, 8 Concrete tile, CASING JOINTS: Threaded. X

Blank casing diameter: 2 in. to 5 ft., Dia. 2 in. to 5 ft., Dia. Casing height above land surface: 0 in., weight 40 lbs./ft. Wall thickness or gauge No. sch. 40

TYPE OF SCREEN OR PERFORATION MATERIAL: 7 PVC, 10 Asbestos-cement

SCREEN OR PERFORATION OPENINGS ARE: 3 Mill slot, 11 None (open hole)

SCREEN-PERFORATED INTERVALS: From 20 ft. to 5 ft. GRAVEL PACK INTERVALS: From 20 ft. to 4 ft.

6 GROUT MATERIAL: 2 Cement grout, 3 Bentonite, 4 Other. Grout Intervals: From 4 ft. to 2 ft., From 2 ft. to 0 ft.

What is the nearest source of possible contamination: 11 Fuel storage, 16 Other (specify below). Direction from well? unknown

Table with columns: FROM, TO, LITHOLOGIC LOG, FROM, TO, PLUGGING INTERVALS. Rows: 0-12 (silt, clayey, greenish gray brown shale), 12-17 (shale, sandy, clayey, silt, yellow brown shale), 17-20 (shale, weathered, clayey, sandy). MW5

7 CONTRACTOR'S OR LANDOWNER'S CERTIFICATION: This water well was (1) constructed, (2) reconstructed, or (3) plugged under my jurisdiction and was completed on (mo/day/year) 05-06-93 and this record is true to the best of my knowledge and belief. Kansas Water Well Contractor's License No. 527 This Water Well Record was completed on (mo/day/yr) 11-28-93 under the business name of GeoCore Services, Inc. by (signature) Dale Rohlf

INSTRUCTIONS: Use typewriter or ball point pen. PLEASE PRESS FIRMLY and PRINT clearly. Please fill in blanks, underline or circle the correct answers. Send top three copies to Kansas Department of Health and Environment, Bureau of Water, Topeka, Kansas 66620-0001. Telephone: 913-296-5545. Send one to WATER WELL OWNER and retain one for your records.