


**36' north of center of 14th Street, 30' west of center of 'L' Street**

3] LOCATE WELL'S LOCATION WITH AN "X" IN SECTION BOX:	4] DEPTH OF COMPLETED WELL.....	25.5 ft.	ELEVATION:	
	Depth(s) Groundwater Encountered	NA	# 1	# 2

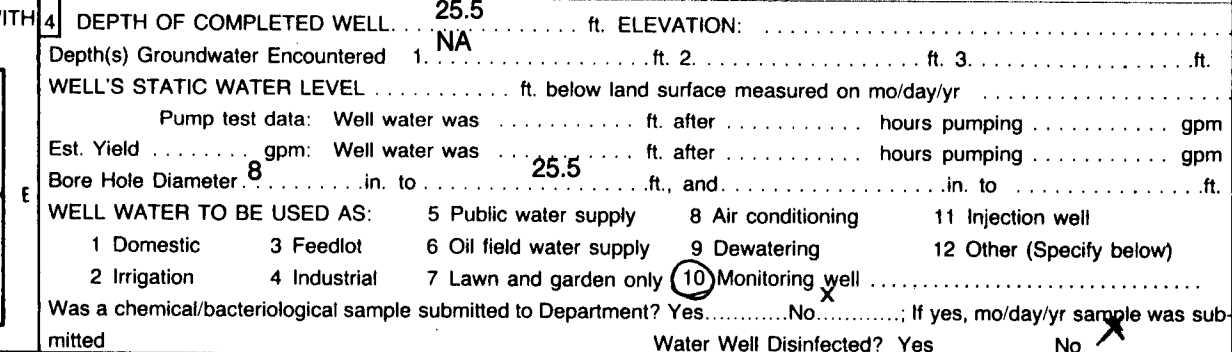

TYPE OF SCREEN OR PERFORATION MATERIAL:

1 Steel	3 Stainless steel	5 Fiberglass	7 PVC	10 Asbestos-cement
2 Brass	4 Galvanized steel	6 Concrete tile	8 RMP (SR)	11 Other (specify) .....
			9 ABS	12 None used (open hole)

SCREEN OR PERFORATION OPENINGS ARE:

1 Continuous slot	3 Mill slot	5 Gauzed wrapped	8 Saw cut	11 None (open hole)
2 Louvered shutter	4 Key punched	6 Wire wrapped	9 Drilled holes	
		7 Torch cut	10 Other (specify) .....	

SCREEN-PERFORATED INTERVALS:	From	25	ft. to	5	ft., From		ft. to		ft.
	From		ft. to		ft., From		ft. to		ft.
GRAVEL PACK INTERVALS:	From	25	ft. to	4	ft., From		ft. to		ft.
	From		ft. to		ft., From		ft. to		ft.

6 GROUT MATERIAL: 1 Neat cement 2 Cement grout 3 Bentonite 4 Other  
Grout Intervals: From 4 ft. to 2 ft., From 2 ft. to 0 ft., From ft. to ft.

What is the nearest source of possible contamination:			
1 Septic tank	4 Lateral lines	7 Pit privy	10 Livestock pens
2 Sewer lines	5 Cess pool	8 Sewage lagoon	11 Fuel storage
3 Watertight sewer lines	6 Seepage pit	9 Feedyard	12 Fertilizer storage
Direction from well?	unknown		13 Insecticide storage
			14 Abandoned water well
			15 Oil well/Gas well
			16 Other (specify below)
			unknown

[illegible]

7 CONTRACTOR'S OR LANDOWNER'S CERTIFICATION: This water well was (1) constructed, (2) reconstructed, or (3) plugged under my jurisdiction and was completed on (mo/day/year) 05-10-93 and this record is true to the best of my knowledge and belief. Kansas Water Well Contractor's License No. 527 This Water Well Record was completed on (mo/day/yr) 11-28-93 under the business name of GeoCore Services, Inc. by (signature) [Signature]