


1 LOCATION OF WATER WELL:		Fraction	Section Number	Township Number	Range Number
County: Republic		NE ¼ NE ¼ NW ¼	25	T 3 S	R 3 E/W

Distance and direction from nearest town or city street address of well if located within city?
 Approximately 4 miles south and 1½ miles east of Belleville

2 WATER WELL OWNER: Republic County
 RR#, St. Address, Box #: P.O. Box 429 Board of Agriculture, Division of Water Resources
 City, State, ZIP Code: Belleville, KS 66935 Application Number:

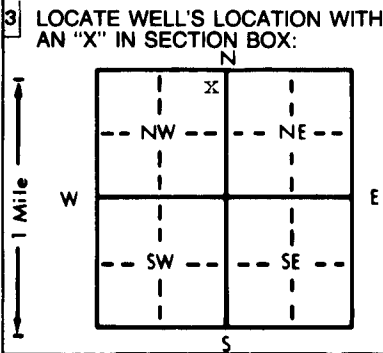

4 DEPTH OF COMPLETED WELL: 20 ft. ELEVATION: unknown

Depth(s) Groundwater Encountered 1. ft. 2. ft. 3. ft.

WELL'S STATIC WATER LEVEL . . . 9.4 . . . ft. below land surface measured on mo/day/yr . . . 2-17-94

Pump test data: Well water was not ch'd ft. after hours pumping gpm

Est. Yield unknown gpm: Well water was ft. after hours pumping gpm

Bore Hole Diameter . . . 9 . . . in. to . . . 18 . . . ft., and in. to ft.

WELL WATER TO BE USED AS:

5 Public water supply	8 Air conditioning	11 Injection well
1 Domestic	3 Feedlot	6 Oil field water supply
2 Irrigation	4 Industrial	7 Lawn and garden only
		10 Monitoring well

12 Other (Specify below)

Was a chemical/bacteriological sample submitted to Department? Yes No X; If yes, mo/day/yr sample was submitted

Water Well Disinfected? Yes No X

5 TYPE OF BLANK CASING USED:

1 Steel	3 RMP (SR)	6 Asbestos-Cement	9 Other (specify below)
2 PVC	4 ABS	7 Fiberglass	

CASING JOINTS: Glued Clamped
 Welded Threaded X

Blank casing diameter 4 in. to 8 ft., Dia in. to ft., Dia in. to ft.

Casing height above land surface 24 in., weight 2.07 lbs./ft. Wall thickness or gauge No. . . . 237

TYPE OF SCREEN OR PERFORATION MATERIAL:

1 Steel	3 Stainless steel	5 Fiberglass	8 RMP (SR)	10 Asbestos-cement
2 Brass	4 Galvanized steel	6 Concrete tile	9 ABS	11 Other (specify)
				12 None used (open hole)

SCREEN OR PERFORATION OPENINGS ARE:

1 Continuous slot	3 Mill slot	5 Gauzed wrapped	8 Saw cut	11 None (open hole)
2 Louvered shutter	4 Key punched	6 Wire wrapped	9 Drilled holes	
		7 Torch cut	10 Other (specify)	

SCREEN-PERFORATED INTERVALS: From 8 ft. to 18 ft., From ft. to ft.

GRAVEL PACK INTERVALS: From 4 ft. to 18 ft., From ft. to ft.

6 GROUT MATERIAL: 1 Neat cement 2 Cement grout 3 Bentonite 4 Other Benotnite Holeplug

Grout Intervals: From 0 ft. to 2 ft., From ft. to ft., From 2 ft. to 4 ft.

What is the nearest source of possible contamination:

1 Septic tank	4 Lateral lines	7 Pit privy	10 Livestock pens	14 Abandoned water well
2 Sewer lines	5 Cess pool	8 Sewage lagoon	11 Fuel storage	15 Oil well/Gas well
3 Watertight sewer lines	6 Seepage pit	9 Feedyard	12 Fertilizer storage	16 Other (specify below)
			13 Insecticide storage	N/A

Direction from well? How many feet?

FROM	TO	LITHOLOGIC LOG	FROM	TO	PLUGGING INTERVALS
0	4	Topsoil			
4	9	Clay, brown			
9	12	Clay, tan with claiche			
12	18	Clay, tan with some limestone gravel			

7 CONTRACTOR'S OR LANDOWNER'S CERTIFICATION: This water well was (1) constructed, (2) reconstructed, or (3) plugged under my jurisdiction and was completed on (mo/day/year) 2-17-94 and this record is true to the best of my knowledge and belief. Kansas Water Well Contractor's License No. 185 This Water Well Record was completed on (mo/day/yr) 2-28-94 under the business name of Clarke Well & Equipment, Inc. by (signature) *Clarke Well & Equipment, Inc.*

OFFICE USE ONLY
T
R
EW
SEC.
1/4
1/4
1/4