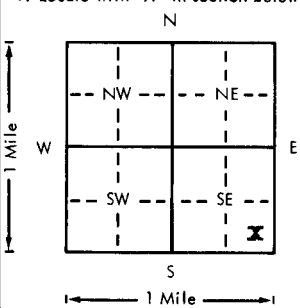


USE TYPEWRITER OR BALL
POINT PEN-PRESS FIRMLY,
PRINT CLEARLY.

WATER WELL RECORD
KSA 82a-1201-1215

Kansas Department of Health and
Environment-Division of Environment
(Water well Contractors)
Topeka, Kansas 66620

1. Location of well:	County Republic	Fraction SE 1/4 SE 1/4 SE 1/4	Section number 32	Township number T 3 S	Range number R 3 W E/W
2. Distance and direction from nearest town or city: Street address of well location if in city: 5 S - 1 W of Belleville			3. Owner of well: Roy L. Jensby R.R. or street: City, state, zip code: Webber, Kansas 66970		
4. Locate with "X" in section below: Sketch map: 			6. Bore hole dia. 8 in. Completion date 9/7/1979 Well depth 108 ft.		
			7. <input checked="" type="checkbox"/> Cable tool <input checked="" type="checkbox"/> Rotary <input type="checkbox"/> Driven <input type="checkbox"/> Dug <input type="checkbox"/> Hollow rod <input type="checkbox"/> Jetted <input type="checkbox"/> Bored <input type="checkbox"/> Reverse rotary		
			8. Use: <input checked="" type="checkbox"/> Domestic <input type="checkbox"/> Public supply <input type="checkbox"/> Industry <input type="checkbox"/> Irrigation <input type="checkbox"/> Air conditioning <input type="checkbox"/> Stock <input type="checkbox"/> Lawn <input type="checkbox"/> Oil field water <input type="checkbox"/> Other		
			9. Casing: Material PVC Height: Above grade Threaded <input type="checkbox"/> Welded <input type="checkbox"/> Surface 12 in. RMP PVC <input checked="" type="checkbox"/> Weight 3 lbs./ft. Dia. 5 in. to 108 ft. depth Wall Thickness: inches or Dia. 5 in. to 108 ft. depth 3.25		
5. Type and color of material			From	To	10. Screen: Manufacturer's name Pumpco Supply, Inc. Type PVC Dia. 5 Slot 1/16 Length 20 Set between 88 ft. and 108 ft. Gravel pack? <input checked="" type="checkbox"/> Size range of material 1/8-4
Top soil & clay			0	45	11. Static water level: 45 ft. below land surface Date 9/7/1979 mo./day/yr.
Sandrock			45	58	12. Pumping level below land surfaces: 100 ft. after 1 hrs. pumping 10 g.p.m. ft. after hrs. pumping g.p.m. Estimated maximum yield 12 g.p.m.
Clay			58	62	13. Water sample submitted: mo./day/yr. <input type="checkbox"/> Yes <input checked="" type="checkbox"/> No Date
Sandrock			62	70	14. Well head completion: <input type="checkbox"/> Pitless adapter 12 inches above grade
Clay			70	88	15. Well grouted? <input checked="" type="checkbox"/> With: <input checked="" type="checkbox"/> Neat cement <input type="checkbox"/> Bentonite <input type="checkbox"/> Concrete Depth: From 0 ft. to 10 ft.
Sandrock			88	90	16. Nearest source of possible contamination: None ft. Direction Type Well disinfected upon completion? <input checked="" type="checkbox"/> Yes <input type="checkbox"/> No
Clay & limerock			90	108	17. Pump: <input checked="" type="checkbox"/> Not installed Manufacturer's name Model number HP Volts Length of drop pipe ft. capacity g.p.m. Type: <input type="checkbox"/> Submersible <input type="checkbox"/> Turbine <input type="checkbox"/> Jet <input type="checkbox"/> Reciprocating <input type="checkbox"/> Centrifugal <input type="checkbox"/> Other
(Use a second sheet if needed)					
18. Elevation: 1500 Topography: <input checked="" type="checkbox"/> Hill <input type="checkbox"/> Slope <input type="checkbox"/> Upland <input type="checkbox"/> Valley	19. Remarks:		20. Water well contractor's certification: This well was drilled under my jurisdiction and this report is true to the best of my knowledge and belief. Cox - Beswick 361 Business name License No. Address Clifton, Kansas 66937 Signed Francis Cox Date 9-8-79 Authorized representative		