USE TYPEWRITER OR BALL POINT PEN-PRESS FIRMLY, PRINT CLEARLY.

WATER WELL RECORD
KSA 82a-1201-1215

CAB

Kansas Department of Health and Environment-Division of Environment
(Water well Contractors)
Topeka, Kansas 66620

1. Location of well:	County	Fraction	Section number	Township number	Range number
	Decatur	NW 1/4 NE 1/4 SW 1/4	3	T 3 S	R 30 E (W)

2. Distance and direction from nearest town or city: 8 W of Oberlin
Street address of well location if in city:

3. Owner of well: Henry Euhns
R.R. or street:
City, state, zip code: Oberlin, Ks 67749

4. Locate with "X" in section below:

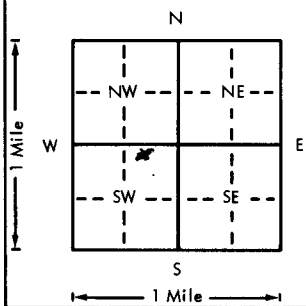

Sketch map:

6. Bore hole dia. 27 in. Completion date 5-20-75
Well depth 165 ft.

7. __ Cable tool ✓ Rotary __ Driven __ Dug
__ Hollow rod __ Jetted __ Bored __ Reverse rotary

8. Use: __ Domestic __ Public supply __ Industry
✓ Irrigation __ Air conditioning __ Stock
__ Lawn __ Oil field water __ Other

9. Casing: Material Asb-C Height: (Above) or below
Threaded ___ Welded ___ Surface 10 in.
RMP ___ PVC ___ Weight 38.46 lbs./ft.
Dia. 16 in. to 105 ft. depth Wall Thickness: inches or
Dia. ___ in. to ___ ft. depth gage No. 5/8

5. Type and color of material	From	To
Top soil	0	20
clay + sand	20	95
Limestone + clay	105	109
sand	109	113
Limestone + clay	113	121
sand	121	124
Limestone + clay	124	127
Sandy clay	127	146
sand	146	160
shale	160	165
(Use a second sheet if needed)		

10. Screen: Manufacturer's name John Mansuell
Type Asb-C Dia. 16
(Slot)/gauze 1/8 Length 60'
Set between 105 ft. and 165 ft.
___ ft. and ___ ft.
Gravel pack? yes Size range of material 1/4

11. Static water level: mo./day/yr.
100 ft. below land surface Date 5/20/75

12. Pumping level below land surfaces:
155 ft. after 6 hrs. pumping 325 g.p.m.
___ ft. after ___ hrs. pumping ___ g.p.m.
Estimated maximum yield 325 g.p.m.

13. Water sample submitted: mo./day/yr.
___ Yes ✓ No Date ___

14. Well head completion:
___ Pitless adapter 10 Inches above grade

15. Well grouted? yes
With: ___ Neat cement ___ Bentonite X Concrete
Depth: From 0 ft. to 12 ft.

16. Nearest source of possible contamination:
ft. 100 Direction NE Type Draw
Well disinfected upon completion? ✓ Yes ___ No

17. Pump: ___ Not installed
Manufacturer's name Western Land Roller
Model number Turbine HP 25 Volts 440
Length of drop pipe 160 ft. capacity 325 g.p.m.
Type:
___ Submersible ✓ Turbine
___ Jet ___ Reciprocating
___ Centrifugal ___ Other

T 3 R 30 E (W) Sec 3 1/4 NW 1/4 NE 1/4 SW

18. Elevation:

Topography:
___ Hill
✓ Slope
___ Upland
___ Valley

19. Remarks: 2785 (TOPO)

20. Water well contractor's certification:
This well was drilled under my jurisdiction and this report is true to the best of my knowledge and belief.
Cooper Drilling 114
Business name License No.
Address Selden Ks.
Signed Elmer Cordu Date 12-10-75
Authorized representative

Forward the white, blue and pink copies to the Department of Health and Environment

Form WWC-5