USE TYPEWRITER OR BALL POINT PEN-PRESS FIRMLY, PRINT CLEARLY.

DAG

WATER WELL RECORD
KSA 82a-1201-1215

Kansas Department of Health and Environment-Division of Environment
(Water well Contractors)
Topeka, Kansas 66620

1. Location of well:	County	Fraction	Section number	Township number	Range number
	Rawlins	NE 1/4 NE 1/4 SE 1/4	24	T 3 S	R 31 E (W)

2. Distance and direction from nearest town or city: 85 - 2E - ½S of Herndon
Street address of well location if in city:

3. Owner of well: Mrs. Anna Lederberg
R.R. or street: Lederberg
City, state, zip code: Oberlin, Ks.

4. Locate with "X" in section below:

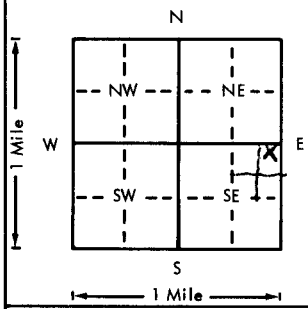

Sketch map:

5. Type and color of material	From	To
Topsoil	0	70
sand + clay	70	98
shale	98	99

(Use a second sheet if needed)

6. Bore hole dia. 5 in. Completion date 6/13/75
Well depth 98 ft.

7. __ Cable tool ✓ Rotary __ Driven __ Dug
__ Hollow rod __ Jetted __ Bored __ Reverse rotary

8. Use: ✓ Domestic __ Public supply __ Industry
__ Irrigation __ Air conditioning __ Stock
__ Lawn __ Oil field water __ Other

9. Casing: Material RMP
Threaded ___ Welded ___
RMP ✓ PVC ___
Dia. 5 in. to 84 ft. depth
Dia. ___ in. to ___ ft. depth
Height: Above or below Surface 12 in.
Weight 1.81 lbs./ft.
Wall Thickness: inches or gage No. 250

10. Screen: Manufacturer's name Pump Co.
Type PVC Dia. 5"
Slot/gauze 132 Length 14'
Set between 84 ft. and 98 ft.
___ ft. and ___ ft.
Gravel pack? yes Size range of material 132

11. Static water level: mo./day/yr.
72 ft. below land surface Date 6/13/75

12. Pumping level below land surfaces: Not tested
___ ft. after ___ hrs. pumping ___ g.p.m.
___ ft. after ___ hrs. pumping ___ g.p.m.
Estimated maximum yield 5 g.p.m.

13. Water sample submitted: ✓ Yes ___ No Date mo./day/yr. submitted by the customer.

14. Well head completion:
___ Pitless adapter 12 Inches above grade

15. Well grouted? yes
With: ✓ Neat cement ___ Bentonite ___ Concrete
Depth: From 0 ft. to 10 ft.

16. Nearest source of possible contamination:
ft. 100 Direction SE Type Cess Pool
Well disinfected upon completion? ✓ Yes ___ No

17. Pump: ✓ Not installed
Manufacturer's name ___
Model number ___ HP ___ Volts ___
Length of drop pipe ___ ft. capacity ___ g.p.m.
Type:
___ Submersible ___ Turbine
___ Jet ___ Reciprocating
___ Centrifugal ___ Other

18. Elevation:
Topography:
___ Hill
___ Slope
✓ Upland
___ Valley

19. Remarks: 209 (TOPO)

20. Water well contractor's certification:
This well was drilled under my jurisdiction and this report is true to the best of my knowledge and belief.
Cordar Drilling LLC
Business name License No.
Address Selden, Ks.
Signed [signature] Date 12-10-75
Authorized representative

T 3 R 31 (W) E Sec 24 1/4 NE 1/4 NE 1/4 SE 1/4

Forward the white, blue and pink copies to the Department of Health and Environment

Form WWC-5