

(DRL, 7/22/2013)
WATER WELL RECORD

Form WWC-5


Division of Water Resources App. No.

46994

1 LOCATION OF WATER WELL:
 County: Rawlins Fraction NW 1/4 SW 1/4 SW 1/4 NW 1/4
 Street/Rural Address of Well Location; if unknown, distance & direction from nearest town or intersection: If at owner's address, check here
8E 3504 of Alwood KS.

2 WATER WELL OWNER:
 RR#, Street Address, Box #: LYNN WRIGHT
21178 ACHILLES RD.
 City, State, ZIP Code: GEM KS 67734

Section Number 27 Township No. T 3 S Range Number R 32 E W
Global Positioning System (GPS) information:
 Latitude: (in decimal degrees)
 Longitude: (in decimal degrees)
 Elevation:
 Datum: WGS 84, NAD 83, NAD 27
 Collection Method:
 GPS unit (Make/Model:)
 Digital Map/Photo, Topographic Map, Land Survey
 Est. Accuracy: <3 m, 3-5 m, 5-15 m, >15 m

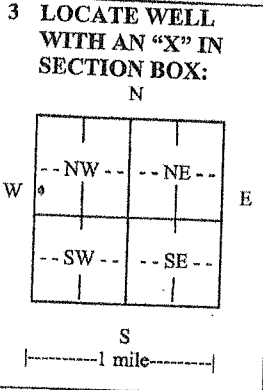

4 DEPTH OF COMPLETED WELL 2.17 ft.
 Depth(s) Groundwater Encountered (1) 1.75 ft. (2) ft. (3) ft.
 WELL'S STATIC WATER LEVEL 1.75 ft. below land surface measured on mo/day/yr.....
 Pump test data: Well water was ft. after hours pumping gpm
 EST. YIELD gpm. Well water was ft. after hours pumping gpm
 Bore Hole Diameter in. to ft., and in. to ft.
 WELL WATER TO BE USED AS: Public water supply Geothermal Injection well
 Domestic Feedlot Oil field water supply Dewatering Other (Specify below)
 Irrigation Industrial Domestic-lawn & garden Monitoring well
 Was a chemical/bacteriological sample submitted to Department? Yes No
 If yes, mo/day/yr sample was submitted.....
 Water well disinfected? Yes No

5 TYPE OF CASING USED: Steel PVC Other
 CASING JOINTS: Glued Clamped Welded Threaded
 Casing diameter 12 in. to ft., Diameter in. to ft., Diameter in. to ft.
 Casing height above land surface 12 in., Weight lbs./ft., Wall thickness or gauge No. 910

TYPE OF SCREEN OR PERFORATION MATERIAL:
 Steel Stainless Steel PVC
 Brass Galvanized Steel None used (open hole) Other (Specify)

SCREEN OR PERFORATION OPENINGS ARE:
 Continuous slot Mill slot Gauze wrapped Torch cut Drilled holes None (open hole)
 Louvered shutter Key punched Wire wrapped Saw cut Other (specify)

SCREEN-PERFORATED INTERVALS: From 2.17 ft. to 15.7 ft., From ft. to ft.
 From ft. to ft., From ft. to ft.
GRAVEL PACK INTERVALS: From 2.17 ft. to 2.0 ft., From ft. to ft.
 From ft. to ft., From ft. to ft.

6 GROUT MATERIAL: Neat cement Cement grout Bentonite Other
 Grout Intervals: From 2.0 ft. to 0 ft., From ft. to ft., From ft. to ft.
 What is the nearest source of possible contamination:
 Septic tank Lateral lines Pit privy Livestock pens Insecticide storage Other (specify below)
 Sewer lines Cesspool Sewage lagoon Fuel storage Abandoned water well
 Watertight sewer lines Seepage pit Feedyard Fertilizer storage Oil well/gas well
 Direction from well NONE Distance from well

FROM	TO	LITHOLOGIC LOG	FROM	TO	LITHO. LOG (cont.) or PLUGGING INTERVALS
0	70	TOP	200	212	Sand
70	85	Clay	212	217	Shale
85	95	Sand			
95	115	Clay & Sand			
115	135	limestone			
135	150	Sand			
150	165	Clay			
165	175	limestone & sand			
175	180	clay & limestone			
180	200	Clay & fine sand			

7 CONTRACTOR'S OR LANDOWNER'S CERTIFICATION: This water well was constructed, reconstructed, or plugged under my jurisdiction and was completed on (mo/day/year) 6-2-13 and this record is true to the best of my knowledge and belief.
 Kansas Water Well Contractor's License No. N/A This Water Well Record was completed on (mo/day/year) 6-23-13
 under the business name of LYNN WRIGHT by (signature) Lynn Wright
INSTRUCTIONS: Use typewriter or ball point pen. PLEASE PRESS FIRMLY and PRINT clearly. Please fill in blanks and check the correct answers. Send three copies (white, blue, pink) to Kansas Department of Health and Environment, Bureau of Water, Geology Section, 1000 SW Jackson St., Suite 420, Topeka, Kansas 66612-1367. Telephone 785-296-5524. Send one copy to WATER WELL OWNER and retain one for your records. Include fee of \$5.00 for each constructed well. Visit us at <http://www.kdheks.gov/waterwell/index.html>.
 KSA 82a-1212

White