


USE TYPEWRITER OR BALL POINT PEN-PRESS FIRMLY, PRINT CLEARLY.

WATER WELL RECORD
KSA 82a-1201-1215

Kansas Department of Health and Environment-Division of Environment
(Water well Contractors)
Topeka, Kansas 66620

1. Location of well: County Rawlins Fraction CH NW Section number 8 Township number T 3 S R 32 E/W

2. Distance and direction from nearest town or city: 5 miles East of Atwood, Kansas
Street address of well location if in city: _____
3. Owner of well: Marvin F. Holle
R.R. or street: _____
City, state, zip code: Ludell, Kansas 67744

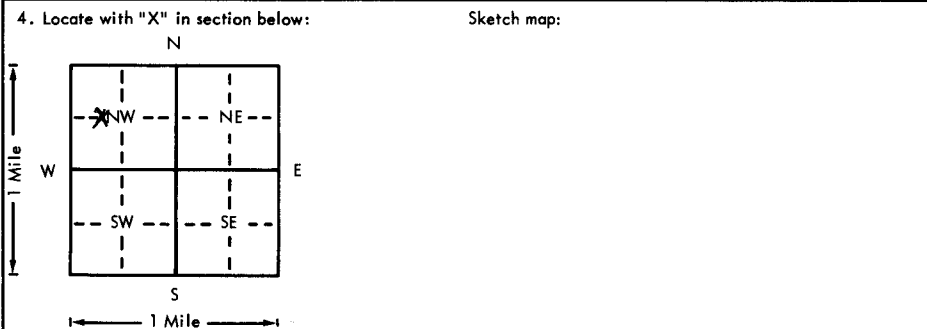

6. Bore hole dia. 8 in. Completion date _____
Well depth 177 ft. 9-8-84

7. Cable tool Rotary Driven Dug
 Hollow rod Jetted Bored Reverse rotary

8. Use: Domestic Public supply Industry
 Irrigation Air conditioning Stock
 Lawn Oil field water Other

9. Casing: Material PVC Height: Above or below
Threaded Welded Surface 16 in.
RMP PVC Weight 160 lbs./ft.
Dia. 4 in. to 177 ft. depth Wall Thickness: inches or
Dia. _____ in. to _____ ft. depth gage No. _____

5. Type and color of material

	From	To
Topsoil	0	4
Clay	01	4 100
Limerock	20	100 120
Silt sand	02	120 150
Sandy clay	04	150 164
sm. gr - loose	13	164 174
shale	19	174 177

10. Screen: Manufacturer's name Gater
Type PVC Dia. 4
Slot/gauze 010 Length 10'
Set between 167 ft. and 177 ft.
ft. and _____ ft.
Gravel pack? Size range of material Pea

11. Static water level: _____ mo./day/yr.
167 ft. below land surface Date 10-20-84

12. Pumping level below land surfaces:
170 ft. after _____ hrs. pumping 2 g.p.m.
_____ ft. after _____ hrs. pumping _____ g.p.m.
Estimated maximum yield 3+ g.p.m.

13. Water sample submitted: _____ mo./day/yr.
Yes No Date _____

14. Well head completion:
 Pitless adapter 16 Inches above grade

15. Well grouted? _____
With: _____ Neat cement _____ Bentonite Concrete
Depth From 5 ft. to 20 ft.

16. Nearest source of possible contamination: None
ft. _____ Direction _____ Type _____
Well disinfected upon completion? _____ Yes No

17. Pump: _____ Not installed
Manufacturer's name _____
Model number _____ HP _____ Volts _____
Length of drop pipe 174 ft. capacity 2 g.p.m.
Type:
 Submersible Turbine
 Jet Cylinder Reciprocating
 Centrifugal Other

18. Elevation: _____
19. Remarks: _____
(Use a second sheet if needed)

Topography:
 Hill
 Slope
 Upland
 Valley

20. Water well contractor's certification:
This well was drilled under my jurisdiction and this report is true to the best of my knowledge and belief.
Rob Wilson Well Drilling 2761A
Business name _____ License No. _____
Address McCabe Ave RR4
Signed Rob Wilson Date 12-28-84
Authorized representative

T
R
E
S
C
H
NW