


1] LOCATION OF WATER WELL: County: Rawlins	Fraction NW 1/4 NW 1/4 SE 1/4	Section Number 8	Township Number T 3 S	Range Number R 33 E/W
--	---	----------------------------	---------------------------------	---

Distance and direction from nearest town or city street address of well if located within city?
113 State Street, Atwood, Kansas

2] WATER WELL OWNER: **The Macfee Oil Co.**
 RR#, St. Address, Box# : **707 South 3rd**
 City, State, ZIP Code : **Atwood, Kansas 67730**
 Board of Agriculture, Division of Water Resources
 Application Number:

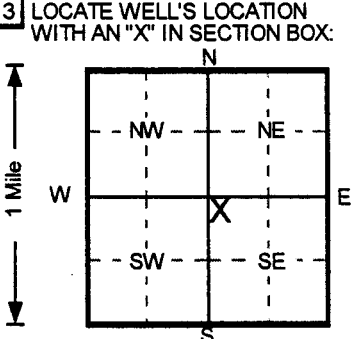

4] DEPTH OF COMPLETED WELL **12** ft. ELEVATION: **2849.61**
 Depth(s) Groundwater Encountered 1..... ft. 2..... ft. 3..... ft.
 WELL'S STATIC WATER LEVEL ft. below land surface measured on mo/day/yr
 Pump test data: Well water was **NA** ft. after hours pumping gpm
 Est. Yield .. **NA** .. gpm: Well water was ft. after hours pumping gpm
 Bore Hole Diameter **8** in. to **12** ft., and..... in. to..... ft.
 WELL WATER TO BE USED AS: 5 Public water supply 8 Air conditioning 11 Injection well
 1 Domestic 3 Feedlot 6 Oil field water supply 9 Dewatering 12 Other (Specify below)
 2 Irrigation 4 Industrial 7 Lawn and garden only **10** Monitoring well
 Was a chemical/bacteriological sample submitted to Department? Yes.....No.....; If yes, mo/day/yr sample was submitted
 Water Well Disinfected? Yes No

5] TYPE OF BLANK CASING USED:
 1 Steel 3 RMP (SR) 5 Wrought iron 8 Concrete tile CASING JOINTS: Glued Clamped
2 PVC 4 ABS 6 Asbestos-Cement 9 Other (specify below) Welded
 7 Fiberglass Threaded.
 Blank casing diameter **4** in. to **7** ft., Dia in. to ft., Dia in. to ft.
 Casing height above land surface **-6.6** in., weight **Sch 40** lbs./ft. Wall thickness or gauge No.
 TYPE OF SCREEN OR PERFORATION MATERIAL **7** PVC 10 Asbestos-cement
 1 Steel 3 Stainless steel 5 Fiberglass 8 RMP (SR) 11 Other (specify)
 2 Brass 4 Galvanized steel 6 Concrete tile 9 ABS 12 None used (open hole)
 SCREEN OR PERFORATION OPENINGS ARE:
 1 Continuous slot **3** Mill slot 5 Gauzed wrapped 8 Saw cut 11 None (open hole)
 2 Louvered shutter 4 Key punched 6 Wire wrapped 9 Drilled holes
 7 Torch cut 10 Other (specify)
 SCREEN-PERFORATED INTERVALS: From **7** ft. to **12** ft., From ft. to ft.
 From ft. to ft., From ft. to ft.
 GRAVEL PACK INTERVALS: From **6** ft. to **12** ft., From ft. to ft.
 From ft. to ft., From ft. to ft.

6] GROUT MATERIAL: 1 Neat cement **2** Cement grout **3** Bentonite 4 Other
 Grout Intervals: From **0** ft. to **4** ft., From **4** ft. to **6** ft., From ft. to ft.
 What is the nearest source of possible contamination:
 1 Septic tank 4 Lateral lines 7 Pit privy 10 Livestock pens 14 Abandoned water well
 2 Sewer lines 5 Cess pool 8 Sewage lagoon 11 Fuel storage 15 Oil well/Gas well
 3 Watertight sewer lines 6 Seepage pit 9 Feedyard 12 Fertilizer storage **16** Other (specify below)
Former Tank Basin
 13 Insecticide storage
 Direction from well? **North** How many feet? **65**

FROM	TO	LITHOLOGIC LOG	FROM	TO	PLUGGING INTERVALS
0	0.5	Cement,			
0.5	1.5	Sand, Brown			
1.5	3	Clay, Dark Brown			
3	10	Silt, Brown			
10	12	Clay, Brown			
					SVE11, Tag # 00275316, Flushmount
					Project Name: Macfee Oil Co.
					GeoCore # 677, KDHE # U6-077-485

7] CONTRACTOR'S OR LANDOWNER'S CERTIFICATION: This water well was **(1)** constructed, (2) reconstructed, or (3) plugged under my jurisdiction and was completed on (mo/day/year) **9/16/98** and this record is true to the best of my knowledge and belief. Kansas Water Well Contractor's License No. **527** This Water Well Record was completed on (mo/day/yr) **10/2/98** under the business name of **GeoCore Services, Inc.** by (signature) *Dale Robb*

OFFICE USE ONLY
T
R
EM
SEC
1/4
1/4
1/4