


1 LOCATION OF WATER WELL:	Fraction	Section Number	Township Number	Range Number
County: Rawlins	SW ¼ SE ¼ SE ¼	8	3	33

Distance and direction from nearest town or city street address of well if located within city?

2 WATER WELL OWNER: **Ginther Oil**
 RR#, St. Address, Box # **102 Grant St** Board of Agriculture, Division of Water Resources
 City, State, ZIP Code : **Atwood, KS 67730** Application Number:

3 MARK WELL'S LOCATION WITH AN "X" IN SECTION BOX:

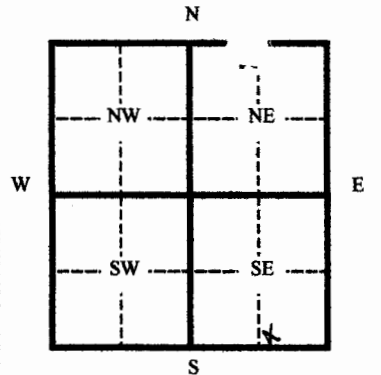

4 DEPTH OF WELL 20.11 ft.

WELL'S STATIC WATER LEVEL Dry ft.

- WELL WAS USED AS:
- | | | |
|--------------|------------------------------|--|
| 1 Domestic | 5 Public Water Supply | 9 Dewatering |
| 2 Irrigation | 6 Oil Field Water Supply | <input checked="" type="checkbox"/> 10 Monitoring Well |
| 3 Feedlot | 7 Lawn and Garden (domestic) | 11 Injection Well |
| 4 Industrial | 8 Air Conditioning | 12 Other _____ |

Was a chemical/bacteriological sample submitted to Department? Yes ___ No ___
 If yes, mo/day/yr sample was submitted _____
 Water Well Disinfected: Yes ___ No ___

5 TYPE OF BLANK CASING USED:

1 Steel	3 RMP (SR)	5 Wrought	7 Fiberglass	9 Other (specify below)
2 PVC	4 ABC	6 Asbestos-Cement	8 Concrete Tile	

Blank casing diameter _____ in. Was casing pulled? Yes No _____ If yes, how much 3 FT
 Casing height above or below land surface -36 in.

6 GROUT PLUG MATERIAL: 1 Neat cement 2 Cement grout 3 Bentonite 4 Other _____
 Grout Plug Intervals From _____ ft. to _____ ft. From _____ ft. to _____ ft. From _____ ft. to _____ ft.

- What is the nearest source of possible contamination:
- | | | | |
|--------------------------|-------------------|-------------------------|--------------------------|
| 1 Septic tank | 6 Seepage pit | 11 Fuel storage | 16 Other (specify below) |
| 2 Sewer lines | 7 Pit privy | 12 Fertilizer storage | |
| 3 Watertight sewer lines | 8 Sewage lagoon | 13 Insecticide storage | |
| 4 Lateral lines | 9 Feedyard | 14 Abandoned water well | |
| 5 Cess Pool | 10 Livestock pens | 15 Oil well/ Gas well | |

Direction from well? _____ How many feet? _____

FROM	TO	CODE	PLUGGING MATERIALS
3	0		Pulled Casing
20.11	.5		Gravel
.5	0		Topsoil

7 CONTRACTOR'S OR LANDOWNER'S CERTIFICATION: This water well was plugged under my jurisdiction and was completed on (mo/day/yr) 5/23/07 and this record is true to the best of my knowledge and belief. Kansas
 /Water Well Contractor's License No. 554 This Water Well Record was completed on (mo/day/yr) 6-18-07
 by (signature) [Signature] /under the business name of Woofter Pump & Well Inc.

INSTRUCTIONS: Please fill in blanks and circle the correct answers. Send three copies to Kansas Department of Health and Environment, Bureau of Water, 1000 S W Jackson St., Ste. 420, Topeka, Kansas 66620-0001. Telephone: 785-296-3565. Send one to Water Well Owner and retain one for your records.