


1	LOCATION OF WATER WELL:	Fraction	Section Number	Township Number	Range Number
	County: <u>RAWLINS</u>	<u>NE 1/4 NW 1/4 NE 1/4</u>	<u>8</u>	<u>35</u>	<u>33W</u>

Distance and direction from nearest town or city street address of well if located within city?
209 GRANT ATWOOD MW-4

2	WATER WELL OWNER: <u>Rod Beamgard</u>	Board of Agriculture, Division of Water Resources
	RR #, St. Address, Box #: <u>P.O. Box 197</u>	Application Number:
	City, State, ZIP Code: <u>ATWOOD KS 67730</u>	

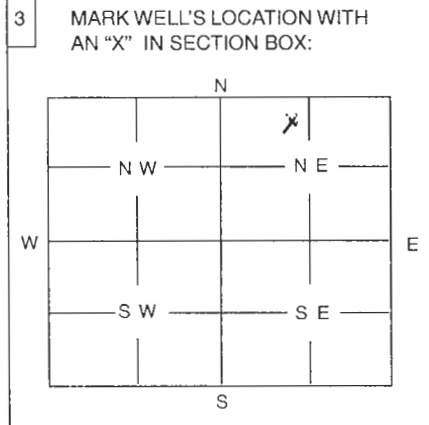

4 DEPTH OF WELL 18 ft

WELL'S STATIC WATER LEVEL 15.5 ft

WELL WAS USED AS:

1 Domestic	5 Public Water Supply	9 Dewatering
2 Irrigation	6 Oil Field Water Supply	<u>10</u> Monitoring Well
3 Feedlot	7 Domestic (Lawn & Garden)	11 Injection Well
4 Industrial	8 Air Conditioning	12 Other

Was a chemical / bacteriological sample submitted to Department? Yes No

If yes, mo/day/yr sample was submitted

Water Well Disinfected: Yes No

5 TYPE OF BLANK CASING USED:

1 Steel	3 RMP (SR)	5 Wrought	7 Fiberglass	9 Other (Specify below)
<u>2 PVC</u>	4 ABS	6 Asbestos-Cement	8 Concrete Tile	

Blank casing diameter 2 in. Was casing pulled? Yes No

Casing height above or below land surface -30 in. If yes, how much

6 GROUT PLUG MATERIAL: 1 Neat cement 2 Cement grout 3 Bentonite 4 Other

Grout Plug Intervals: From 15.5 ft. to 2.5 ft., From ft. to ft., From to ft.

What is the nearest source of possible contamination:

1 Septic tank	6 Seepage pit	<u>11</u> Fuel storage - former	16 Other (specify below)
2 Sewer lines	7 Pit privy	12 Fertilizer storage	
3 Watertight sewer lines	8 Sewage lagoon	13 Insecticide storage	
4 Lateral lines	9 Feedyard	14 Abandoned water well	
5 Cess Pool	10 Livestock pens	15 Oil well/Gas well	

Direction from well? N How many feet? ±30' 10-9-91

FROM	TO	PLUGGING MATERIALS
<u>18</u>	<u>15.5</u>	<u>Silt (accumulated)</u>
<u>15.5</u>	<u>2.5</u>	<u>Bentonite (Hole Plug)</u>
<u>2.5</u>	<u>0</u>	<u>Native Soil</u>

MW-04, installed as part of the R-Care Care Trust Fund investigation (UST), Project Code 46077192, had been lost for several years. B. Heermann located the well cover under the footing of a new shop building built by Dave Brown, Brown's Service. Bell hole dug to access the well casing 2.5' bgl. Casing cut and access gained to insert bentonite & plug the well.

7 CONTRACTOR'S OR LANDOWNER'S CERTIFICATION: This water well was plugged under my jurisdiction and was completed on (mo/day/year) 7-11-07 and this record is true to the best of my knowledge and belief. Kansas Water Well Contractor's License No. 7-16-07 This Water Well Record was completed on (mo/day/year) 7-16-07 under the business name of KDHE by (signature) Bill Heermann, NEDDO

INSTRUCTIONS: Use typewriter or ball point pen. Please press firmly and print clearly. Please fill in blanks, underline or circle the correct answers. Send top three copies to Kansas Department of Health and Environment, Bureau of Water, Topeka, Kansas 66620-0001. Telephone: 785/296-3565. Send one to Water Well Owner and retain one for your records.

LOCATION OF WATER WELL: Rawlins, Frac. NW 1/4 NW 1/4 NE 1/4, Section 8, Township T 3 S, Range R 11 EW

Grant Street, Atwood, Kas. MW 1

WELL OWNER: L.M. Chvatal Oil Co. Address: Box # 151, Atwood, Kas. 67730

WELL'S LOCATION WITHIN SECTION BOX: DEPTH OF COMPLETED WELL 17 ft. ELEVATION: 10-28-91. WELL'S STATIC WATER LEVEL 12.99 ft. below land surface measured on modyayr 10-28-91.

TYPE OF BLANK CASING USED: 1 Steel, 2 RMP (SR), 3 Wrought iron, 4 ABS, 5 Fiberglass, 6 Concrete tile, 7 Other (specify below). SCREEN OR PERFORATION MATERIAL: 1 Steel, 2 Brass, 3 Stainless steel, 4 Galvanized steel, 5 Fiberglass, 6 Concrete tile, 7 RMP (SR), 8 Other (specify).

GROUT MATERIAL: 1 Neat cement, 2 Cement grout, 3 Bentonite, 4 Other. PLUGGING INTERVALS: 5 Clay, grey, silty; 17 Silt, grey, clayey.

LITHOLOGIC LOG table with columns: TO, FROM, LITHOLOGIC LOG, PLUGGING INTERVALS. Rows: 5 Clay, grey, silty; 17 Silt, grey, clayey.

CTOR'S OR LANDOWNER'S CERTIFICATION: This water well was (1) constructed, (2) reconstructed, or (3) plugged under my jurisdiction and was on (modyayr/year) 10-9-91.

CTING: Use typewriter or ball point pen. PLEASE PRINT NAME and PRINT clearly. Please fill in blanks, underline or circle the correct answers. Send top three copies to Kansas Department of Health and Environment, Bureau of Water, Topeka, Kansas 66620-0001.

LOCATION OF WATER WELL: Rawlins, Frac. NW 1/4 NW 1/4 NE 1/4, Section 8, Township T 3 S, Range R 11 EW

202 Grant Street, Atwood, Kas. MW 2

WELL OWNER: L.M. Chvatal Oil Co. Address: Box # 151, Atwood, Kas. 67730

WELL'S LOCATION WITHIN SECTION BOX: DEPTH OF COMPLETED WELL 17 ft. ELEVATION: 10-28-91. WELL'S STATIC WATER LEVEL 12.73 ft. below land surface measured on modyayr 10-28-91.

TYPE OF BLANK CASING USED: 1 Steel, 2 RMP (SR), 3 Wrought iron, 4 ABS, 5 Fiberglass, 6 Concrete tile, 7 Other (specify below). SCREEN OR PERFORATION MATERIAL: 1 Steel, 2 Brass, 3 Stainless steel, 4 Galvanized steel, 5 Fiberglass, 6 Concrete tile, 7 RMP (SR), 8 Other (specify).

GROUT MATERIAL: 1 Neat cement, 2 Cement grout, 3 Bentonite, 4 Other. PLUGGING INTERVALS: 5 Clay, grey, silty; 17 Silt, grey, clayey.

LITHOLOGIC LOG table with columns: TO, FROM, LITHOLOGIC LOG, PLUGGING INTERVALS. Rows: 5 Clay, grey, silty; 17 Silt, grey, clayey.

CTOR'S OR LANDOWNER'S CERTIFICATION: This water well was (1) constructed, (2) reconstructed, or (3) plugged under my jurisdiction and was on (modyayr/year) 10-9-91.

CTING: Use typewriter or ball point pen. PLEASE PRINT NAME and PRINT clearly. Please fill in blanks, underline or circle the correct answers. Send top three copies to Kansas Department of Health and Environment, Bureau of Water, Topeka, Kansas 66620-0001.

LOCATION OF WATER WELL: Rawlins, Frac. NE 1/4 NW 1/4 NE 1/4, Section 8, Township T 3 S, Range R 11 EW

Grant Street, Atwood, Kansas MW 3

WELL OWNER: Rod Beazgard Address: Box # P. O. Box 197, Atwood, Kas. 67730

WELL'S LOCATION WITHIN SECTION BOX: DEPTH OF COMPLETED WELL 17 ft. ELEVATION: 10-28-91. WELL'S STATIC WATER LEVEL 12.07 ft. below land surface measured on modyayr 10-28-91.

TYPE OF BLANK CASING USED: 1 Steel, 2 RMP (SR), 3 Wrought iron, 4 ABS, 5 Fiberglass, 6 Concrete tile, 7 Other (specify below). SCREEN OR PERFORATION MATERIAL: 1 Steel, 2 Brass, 3 Stainless steel, 4 Galvanized steel, 5 Fiberglass, 6 Concrete tile, 7 RMP (SR), 8 Other (specify).

GROUT MATERIAL: 1 Neat cement, 2 Cement grout, 3 Bentonite, 4 Other. PLUGGING INTERVALS: 5 Clay, black, silty; 17 Silt, tan, clayey.

LITHOLOGIC LOG table with columns: TO, FROM, LITHOLOGIC LOG, PLUGGING INTERVALS. Rows: 5 Clay, black, silty; 17 Silt, tan, clayey.

CTOR'S OR LANDOWNER'S CERTIFICATION: This water well was (1) constructed, (2) reconstructed, or (3) plugged under my jurisdiction and was on (modyayr/year) 10-10-91.

CTING: Use typewriter or ball point pen. PLEASE PRINT NAME and PRINT clearly. Please fill in blanks, underline or circle the correct answers. Send top three copies to Kansas Department of Health and Environment, Bureau of Water, Topeka, Kansas 66620-0001.

LOCATION OF WATER WELL: Rawlins, Frac. NE 1/4 NW 1/4 NE 1/4, Section 8, Township T 3 S, Range R 11 EW

204 Grant Street, Atwood, Kansas MW 4

WELL OWNER: Rod Beazgard Address: Box # P. O. Box 197, Atwood, Kas. 67730

WELL'S LOCATION WITHIN SECTION BOX: DEPTH OF COMPLETED WELL 18 ft. ELEVATION: 10-28-91. WELL'S STATIC WATER LEVEL 12.06 ft. below land surface measured on modyayr 10-28-91.

TYPE OF BLANK CASING USED: 1 Steel, 2 RMP (SR), 3 Wrought iron, 4 ABS, 5 Fiberglass, 6 Concrete tile, 7 Other (specify below). SCREEN OR PERFORATION MATERIAL: 1 Steel, 2 Brass, 3 Stainless steel, 4 Galvanized steel, 5 Fiberglass, 6 Concrete tile, 7 RMP (SR), 8 Other (specify).

GROUT MATERIAL: 1 Neat cement, 2 Cement grout, 3 Bentonite, 4 Other. PLUGGING INTERVALS: 6 Clay, brown silty; 12 Silt, dark gray, clay; 17 Silt, light gray.

LITHOLOGIC LOG table with columns: TO, FROM, LITHOLOGIC LOG, PLUGGING INTERVALS. Rows: 6 Clay, brown silty; 12 Silt, dark gray, clay; 17 Silt, light gray.

CTOR'S OR LANDOWNER'S CERTIFICATION: This water well was (1) constructed, (2) reconstructed, or (3) plugged under my jurisdiction and was on (modyayr/year) 10-10-91.

CTING: Use typewriter or ball point pen. PLEASE PRINT NAME and PRINT clearly. Please fill in blanks, underline or circle the correct answers. Send top three copies to Kansas Department of Health and Environment, Bureau of Water, Topeka, Kansas 66620-0001.

Geocore Services, Inc.

DRILLING LOG

Well No. <u>MW 4</u>	Drilling Company <u>GeoCore Services, Inc.</u>	Casing:
Project <u>Chvatal Oil/R Car Care</u>	Drilling Method <u>Hollow Stem Auger</u>	Type <u>PVC</u>
Project Number <u>06077192</u>	Geologist <u>Doug Roy</u>	Diameter <u>2"</u>
Client <u>Beangard</u>	Elevation <u>2842.40'</u>	Length <u>8'</u>
Project Location <u>Atwood, Kansas</u>	Static Water Depth <u>12.06' (csg.)</u>	Screen:
Spot <u>N side of R CAR Care Excav.</u>	Total Depth <u>18'</u>	Diameter <u>2"</u>
<u>NE NW NE 8-T3s-R33w</u>	Boring Diameter <u>7 5/8"</u>	Length <u>10'</u>
Date Drilled <u>10-9-91</u>	Boring: Completed <input checked="" type="checkbox"/> Plugged <input type="checkbox"/>	Slot Size <u>0.010"</u>

Notes	Well Construction	Depth (ft)	Sample No. & Field Analysis	Sample Interval	Graphic Log	Description / Soil Classification (Color, Texture, Structure)
		0	Drager			
Concrete grout		2				Brown silty clay, no odor (possible backfill)
Bentonite grout		4				
		6	Open			
Sand		8				Dark gray clayey silt, slight odor (possible backfill)
Screen		10	400	SS		
		12	▼			
		14				Light gray silt, strong odor
		16				
		18				