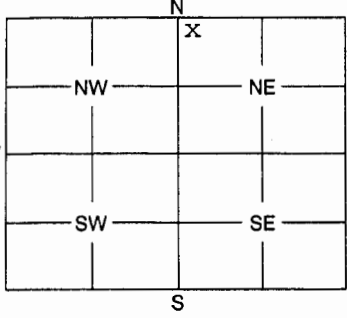


1	LOCATION OF WATER WELL: County: Rawlins	Fraction NW ¼ NE ¼ NE ¼	Section 8	Number	Township 3	Number	Range 33	Number	EW
---	---	-----------------------------------	---------------------	--------	----------------------	--------	--------------------	--------	-----------

Distance and direction from nearest town or city street address of well if located within city?

SE corner of Junction 25 & 36 Hwy

2	WATER WELL OWNER: KDHE T&M 1000 SW Jackson RR #, St. Address, Box #: Topeka, KS City, State, ZIP Code :	Board of Agriculture, Division of Water Resources Application Number:
---	--	--

3	MARK WELL'S LOCATION WITH AN "X" IN SECTION BOX: 	4	DEPTH OF WELL 21.21 ft. WELL'S STATIC WATER LEVEL ft. WELL WAS USED AS: 1 Domestic 2 Irrigation 3 Feedlot 4 Industrial 5 Public Water Supply 6 Oil Field Water Supply 7 Domestic (Lawn & Garden) 8 Air Conditioning 9 Dewatering 10 Monitoring Well MW-12 11 Injection Well 12 Other
---	---	---	--

Was a chemical / bacteriological sample submitted to Department? Yes No
If yes, mo/day/yr sample was submitted

Water Well Disinfected: Yes No

5	TYPE OF BLANK CASING USED: 1 Steel <input checked="" type="checkbox"/> 2 PVC 3 RMP (SR) 4 ABS 5 Wrought 6 Asbestos-Cement 7 Fiberglass 8 Concrete Tile 9 Other (Specify below)	Blank casing diameter 2 in. Casing height above or below land surface 40 in.	Was casing pulled? Yes <input checked="" type="checkbox"/> No If yes, how much 3'
---	---	---	---

6	GROUT PLUG MATERIAL: 1 Neat cement 2 Cement grout <input checked="" type="checkbox"/> 3 Bentonite 4 Other	GROUT PLUG INTERVALS: From 3 ft. to 21.21 ft., From ft. to ft., From ft. to ft.
---	---	---

What is the nearest source of possible contamination:
1 Septic tank 2 Sewer lines 3 Watertight sewer lines 4 Lateral lines 5 Cess pool
6 Seepage pit 7 Pit privy 8 Sewage lagoon 9 Feedyard 10 Livestock pens
 11 Fuel storage 12 Fertilizer storage 13 Insecticide storage 14 Abandoned water well 15 Oil well/Gas well 16 Other (specify below)

Direction from well? How many feet?

FROM	TO	PLUGGING MATERIALS
0	3	native soil
3	21.21	Bentonite

7	CONTRACTOR'S OR LANDOWNER'S CERTIFICATION: This water well was plugged under my jurisdiction and was completed on (mo/day/year) 2-22-08 and this record is true to the best of my knowledge and belief. Kansas Water Well Contractor's License No. 735 This Water Well Record was completed on (mo/day/year) 02-25-08 under the business name of MILCO Environmental Services, Inc. by (signature) <i>[Signature]</i>
---	---

INSTRUCTIONS: Use typewriter or ball point pen. Please press firmly and print clearly. Please fill in blanks, underline or circle the correct answers. Send top three copies to Kansas Department of Health and Environment, Bureau of Water, Geology Section, 1000 SW Jackson St., Ste. 420, Topeka, Kansas 66612-1367. Telephone: 785/296-5522. Send one to Water Well Owner and retain one for your records.