

USE TYPEWRITER OR BALL POINT PEN—PRESS FIRMLY, PRINT CLEARLY.


WATER WELL RECORD  
KSA 82a-1201-1215

BAA

Kansas Department of Health and Environment—Division of Environment (Water well Contractors) Topeka, Kansas 66620

1. Location of well: County RAWLINS Fraction NE 1/4 NE 1/4 NW 1/4 Section number 17 Township number T 3 S R 33 Range number 10W

2. Distance and direction from nearest town or city: NW corner of Atwood 3. Owner of well: DALE NOWKA  
Street address of well location if in city: Rail road Av. R.R. or street: R.R 1  
City, state, zip code: Atwood, KAN. 67730

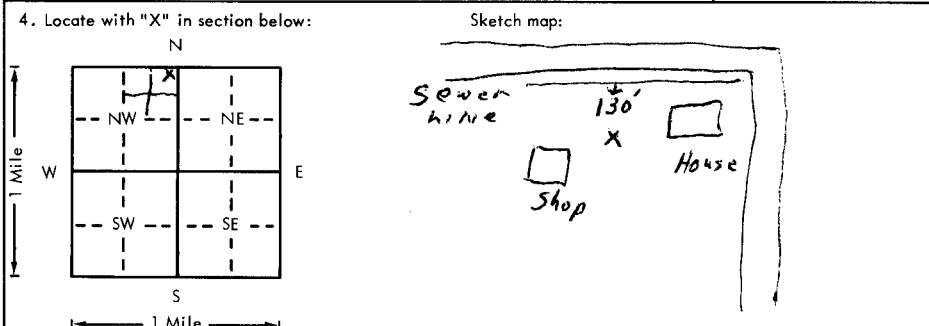

6. Bore hole dia. 8 in. Completion date 10/10/77  
 Well depth 55 ft. 10/10/77  
7.  Cable tool  Rotary  Driven  Dug  
 Hollow rod  Jetted  Bored  Reverse rotary  
8. Use:  Domestic  Public supply  Industry  
 Irrigation  Air conditioning  Stock  
 Lawn  Oil field water  Other  
9. Casing: Material PVC Height: Above or below  
Threaded  Welded  Surface 24 in.  
RMP  PVC  Weight          lbs./ft.  
Dia. 5 in. to 2 ft. depth Wall Thickness: inches or  
Dia. 5 in. to 55 ft. depth gage No. 1320

| 5. Type and color of material  | From | To |
|--------------------------------|------|----|
| Top soil                       | 0    | 5  |
| Clay slick ht Brown            | 5    | 30 |
| Fine sand + clay Brown         | 30   | 35 |
| Fine sand Brown                | 35   | 40 |
| Gravel Brown                   | 40   | 50 |
| Round Rock Brown               | 50   | 53 |
| Shale Blue-Black               | 53   | 55 |
| (Use a second sheet if needed) |      |    |

10. Screen: Manufacturer's name SDR 26 MPI PVC 1120 NSF PV  
Type PVC Dia. 2  
Slot/gauze 1/16 Length 10'  
Set between 45 ft. and 55 ft.  
Gravel pack? yes Size range of material 1/4 to 1/2  
11. Static water level: 30 ft. below land surface Date 10/10/77 mo./day/yr.  
12. Pumping level below land surfaces:  
         ft. after          hrs. pumping          g.p.m.  
         ft. after          hrs. pumping          g.p.m.  
Estimated maximum yield          g.p.m.  
13. Water sample submitted:          mo./day/yr.  
 Yes  No Date           
14. Well head completion:  
         Pitless adapter 24 Inches above grade  
15. Well grouted? yes  
With:          Neat cement          Bentonite  Concrete  
Depth: From 13 ft. to 0 ft.  
16. Nearest source of possible contamination:  
ft. 130 Direction North Type Sewer Line  
Well disinfected upon completion?  Yes  No  
17. Pump:          Not installed  
Manufacturer's name           
Model number          HP          Volts           
Length of drop pipe          ft. capacity          g.p.m.  
Type:  
 Submersible  Turbine  
 Jet  Reciprocating  
 Centrifugal  Other

18. Elevation:  
Topography:  
 Hill  
 Slope  
 Upland  
 Valley

19. Remarks: Dale installed grout + is going to build a 50' by 100' steel building with well in South East corner.

20. Water well contractor's certification:  
This well was drilled under my jurisdiction and this report is true to the best of my knowledge and belief.  
HA Drilling 331  
Business name License No.  
Address Atwood, KAN.  
Signed Harry A. Bryant Date 4/2/77  
Authorized representative

T 3 R 33 S 10 W 17 NE 1/4 NW 1/4