


USE TYPEWRITER OR BALL POINT PEN-PRESS FIRMLY, PRINT CLEARLY.

WATER WELL RECORD
KSA 82a-1201-1215

Kansas Department of Health and Environment-Division of Environment (Water well Contractors) Topeka, Kansas 66620

1. Location of well: County Rawlins Fraction NE 1/4 SE 1/4 NW 1/4 Section number 17 Township number T 3 S Range number R 33

Distance and direction from nearest town or city: 500 ft W edge of Atwood, 1/2 mi.
Street address of well location if in city: Atwood, 1/2 mi.
3. Owner of well: Joe Vap
R.R. or street:
City, state, zip code: Atwood, KS 67730

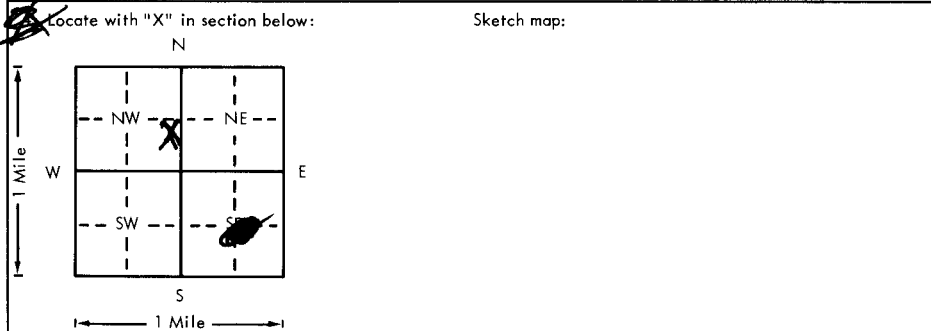

6. Bore hole dia. 3.0 in. Completion date 6-15
Well depth 47 ft.
7. Cable tool Rotary Driven Dug
 Hollow rod Jetted Bored Reverse rotary
8. Use: Domestic Public supply Industry
 Irrigation Air conditioning Stock
 Lawn Oil field water Other
9. Casing: Material PVC Height: Above or below
Threaded Welded Surface 2 1/2" diameter
RMP PVC Height 32 lbs./ft.
Dia. 1.6 in. to 47 ft. depth Wall Thickness: inches or
Dia. 1.6 in. to 47 ft. depth Gage No. 3/4"

5. Type and color of material	From	To
<u>2' top soil</u>	<u>0</u>	<u>10</u>
<u>8' clay</u>	<u>10</u>	<u>20</u>
<u>3' clay</u>	<u>20</u>	<u>30</u>
<u>7' gravel</u>	<u>30</u>	<u>40</u>
<u>2' gravel & clay</u>	<u>40</u>	<u>47</u>
<u>8' coarse loose gravel</u>		
<u>10' loose coarse gravel</u>		
<u>7' shale</u>		

10. Screens: Manufacturer's name Pearless
Type PVC Dia. 1.6"
Slot/gauge _____ Length 20'
Set between 27 ft. and 47 ft.
ft. and _____ ft.
Gravel pack? Size range of material 3/8" to 1/2"
11. Static water level: _____ mo./day/yr.
13 ft. below land surface Date 6-17-79
12. Pumping level below land surfaces:
45 ft. after 3 hrs. pumping 500 g.p.m.
_____ ft. after _____ hrs. pumping _____ g.p.m.
~~Estimated~~ maximum yield 550 g.p.m.
13. Water sample submitted: _____ mo./day/yr.
Yes No Date _____
14. Well head completion:
 Pitless adapter 10" inches above grade
15. Well grouted? yes
With: Neat cement Bentonite Concrete
Depth: From 0 ft. to 10 ft. above gr.
Nearest source of possible contamination:
fr. 650 Direction West Type Creek
Well disinfected upon completion? Yes No
 Pump: _____ Not installed
Manufacturer's name _____
Model number _____ HP _____ Volts _____
Length of drop pipe _____ ft. capacity _____ g.p.m.
Type:
 Submersible Turbine
 Jet Reciprocating
 Centrifugal Other

18. Elevation: _____
Topography: _____ Hill _____ Slope _____ Upland _____ Valley _____
19. Remarks: This is a Rodrill well. He set his old pump back in.
20. Water well contractor's certification:
This well was drilled under my jurisdiction and this report is true to the best of my knowledge and belief.
Jack Pore Drilling - 497
Business name _____ License No. _____
Address 300 S. 1st St. Topeka, KS
Signed Jack Pore Date 6-25
Authorized representative