


1 LOCATION OF WATER WELL: County: **Rawlins** Fraction: **N 1/2 NW 1/4 NW 1/4** Section Number: **20** Township Number: **T 3 S** Range Number: **R 33 EW**

Distance and direction from nearest town or city street address of well if located within city?
 1/4 Mile West of State Highway 25, 1 1/2 Miles South of Atwood, Kansas 52935128B MW-3

2 WATER WELL OWNER: **Rawlins County**
 RR#, St. Address, Box #: **607 Main** Board of Agriculture, Division of Water Resources
 City, State, ZIP Code: **Atwood, Kansas 67730** Application Number:

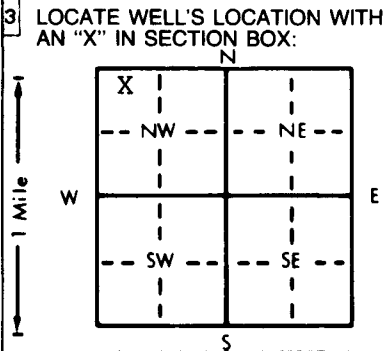

4 DEPTH OF COMPLETED WELL: **140** ft. ELEVATION: **Approx. Surface Elev.: 3049** ft.
 Depth(s) Groundwater Encountered: 1. ft. 2. ft. 3. ft.
 WELL'S STATIC WATER LEVEL: **127.66** ft. below land surface measured on **mo/day/yr 03/08/94**
 Pump test data: Well water was ft. after hours pumping gpm
 Est. Yield gpm: Well water was ft. after hours pumping gpm
 Bore Hole Diameter: **8** in. to **140** ft., and in. to ft.
 WELL WATER TO BE USED AS: 5 Public water supply 8 Air conditioning 11 Injection well
 1 Domestic 3 Feedlot 6 Oil field water supply 9 Dewatering 12 Other (Specify below)
 2 Irrigation 4 Industrial 7 Lawn and garden only **10** Monitoring well **X**
 Was a chemical/bacteriological sample submitted to Department? Yes No **X**; If yes, mo/day/yr sample was submitted
 Water Well Disinfected? Yes No **X**

5 TYPE OF BLANK CASING USED: 1 Steel 3 RMP (SR) 5 Wrought iron 8 Concrete tile CASING JOINTS: Glued Clamped
2 PVC 4 ABS 7 Fiberglass 9 Other (specify below) Welded
 Blank casing diameter: **4** in. to **106** ft., Dia. in. to ft., Dia. in. to ft.
 Casing height above land surface: **36** in., weight lbs./ft. Wall thickness or gauge No. **Schedule 40**
 TYPE OF SCREEN OR PERFORATION MATERIAL: **7** PVC 10 Asbestos-cement
 1 Steel 3 Stainless steel 5 Fiberglass 8 RMP (SR) 11 Other (specify)
 2 Brass 4 Galvanized steel 6 Concrete tile 9 ABS 12 None used (open hole)
 SCREEN OR PERFORATION OPENINGS ARE: 5 Gauzed wrapped 8 Saw cut 11 None (open hole)
 1 Continuous slot **3** Mill slot 6 Wire wrapped 9 Drilled holes
 2 Louvered shutter 4 Key punched 7 Torch cut 10 Other (specify)
 SCREEN-PERFORATED INTERVALS: From **106** ft. to **136** ft., From ft. to ft.
 From ft. to ft., From ft. to ft.
 GRAVEL PACK INTERVALS: From **96** ft. to **140** ft., From ft. to ft.
 From ft. to ft., From ft. to ft.

6 GROUT MATERIAL: **1** Neat cement 2 Cement grout **3** Bentonite 4 Other
 Grout Intervals: From **0.0** ft. to **86** ft., From **86** ft. to **96** ft., From ft. to ft.
 What is the nearest source of possible contamination:
 1 Septic tank 4 Lateral lines 7 Pit privy 10 Livestock pens 14 Abandoned water well
 2 Sewer lines 5 Cess pool 8 Sewage lagoon 11 Fuel storage 15 Oil well/Gas well
 3 Watertight sewer lines 6 Seepage pit 9 Feedyard 12 Fertilizer storage 16 Other (specify below)
 13 Insecticide storage
 Direction from well? How many feet?

FROM	TO	LITHOLOGIC LOG	FROM	TO	PLUGGING INTERVALS
0.0	53.0	Lean Clay; Light Tan			
53.0	58.0	Sand With Caliche			
58.0	66.0	Fine to Medium Sand			
66.0	72.0	Sand With Caliche			
72.0	93.0	Fine Sand With Clay			
93.0	102.0	Sand With Caliche			
102.0	128.0	Fine to Medium Sandstone			
128.0	134.0	Fine to Medium Sand, Trace Coarse			
134.0	140.0	Weathered Shale			

7 CONTRACTOR'S OR LANDOWNER'S CERTIFICATION: This water well was **1** constructed, (2) reconstructed, or (3) plugged under my jurisdiction and was completed on (mo/day/year) **03/04/94** and this record is true to the best of my knowledge and belief. Kansas Water Well Contractor's License No. **416** This Water Well Record was completed on (mo/day/yr) **9-24-94** under the business name of **Terracon Consultants, Inc.** by (signature) *Steve R. Fisher*

INSTRUCTIONS: Use typewriter or ball point pen. PLEASE PRESS FIRMLY and PRINT clearly. Please fill in blanks, underline or circle the correct answers. Send top three copies to Kansas Department of Health and Environment, Bureau of Water, Topeka, Kansas 66620-0001. Telephone: 913-296-5545. Send one to WATER WELL OWNER and retain one for your records.