

USE TYPEWRITER OR BALL POINT PEN-PRESS FIRMLY, PRINT CLEARLY.

T R EW sec 1/4 1/4 1/4 No.

#2


WATER WELL RECORD
KSA 82a-1201-1215

Kansas State Dept. Of Health
(Water Well Contractors)
Forbes-Bldg. 740
Topeka, Kansas 66620

SW 1/4 SE 1/4 NE 1/4

1 Location of well: County Rawlins Township name Atwood Section number 34 Town number 3 Range number 33 W

Distance and direction from nearest town or city: 5 mi, SE of Atwood
Street address of well location if in city:
3 Owner of well: Daniel C Ruda
Address: Atwood Ks 67730

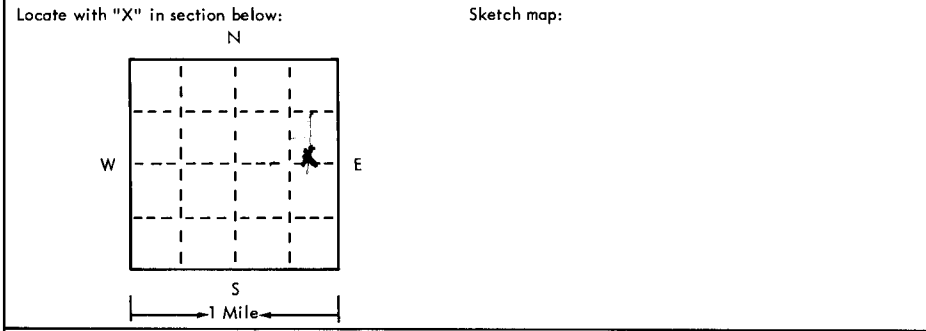

4 Well depth 235 ft. Date of completion 9/75
Well diameter 30 in.
5 Cable tool Rotary Driven Dug
 Hollow rod Jetted Bored Reverse rotary
6 Use: Domestic Public supply Industry
 Irrigation Air conditioning Commercial
 Test well
7 Casing: Material STEEL Height: above/below
Threaded Welded Surface 12 in.
Diam. 10 in. to 235 ft. depth Weight 32 lbs./ft. L
Drive shoe? Yes No

2	Type and color of material	From	To
	<u>top soil & clay</u>	<u>0</u>	<u>180</u>
	<u>8' porous rock 2' clay</u>	<u>180</u>	<u>190</u>
	<u>8' loose porous rock 2' porous</u>	<u>190</u>	<u>200</u>
	<u>10' porous rock strings of clay</u>	<u>200</u>	<u>210</u>
	<u>6' loose porous rock fines sand</u>	<u>210</u>	<u>220</u>
	<u>9' gravel 1' shale</u>	<u>220</u>	<u>230</u>
	<u>5' shale</u>	<u>230</u>	<u>235</u>

8 Screen: Manufacturer W.A. Brown Enterprise
Type free flow Dia. 1 1/2"
Slot gauze Length 40
Set between 195 ft. and 235 ft.
Fittings: 3/4
Gravel pack Yes No Size range of material _____

9 Static water level: 180 ft. below land surface Date 9/75
10 Pumping level below land surfaces:
230 ft. after 10 hrs. pumping 240 g.p.m.
____ ft. after ____ hrs. pumping ____ g.p.m.
Estimated maximum yield 240 g.p.m.

11 Water sample submitted:
 Yes No Date _____

12 Well head completion:
 Pitless adapter Inches above grade

13 Well grouted? Yes No Puddled clay
 Neat cement Bentonite
Depth: From 0 ft. to 10 ft.

14 Nearest source of possible contamination:
ft. _____ Direction _____ Type _____
Well disinfected upon completion? Yes No

15 Pump: Not installed
Manufacturer's name Donalds
Model number 720 HP 25 Volts 440
Length of drop pipe 230 ft. capacity 240 g.p.m.
Type:
 Submersible Turbine
 Jet Reciprocating
 Centrifugal Other

16 Remarks: elevation
Topography:
 Hill
 Slope
 Upland
 Valley

17 Water well contractor's certification:
This well was drilled under my jurisdiction and this report is true to the best of my knowledge and belief.
Jack Cove Drilling 197
Business name License No. _____
Address Atwood Ks
Signed Jack Cove Date 4/76
Authorized representative

MS - 33 W - 34 SW 1/4