

USE TYPEWRITER OR BALL POINT PEN-PRESS FIRMLY, PRINT CLEARLY.


T R EW sec 1/4 1/4 1/4 No.

WATER WELL RECORD
KSA 82a-1201-1215

Kansas State Dept. Of Health
(Water Well Contractors)
Forbes-Bldg. 740
Topeka, Kansas 66620

1 Location of well: County Rawlins Township name Atwood Section number 34 Town number 3 Range number 33 N

Distance and direction from nearest town or city: 5 MI. SE of Atwood
Street address of well location if in city:
3 Owner of well: Dave Ruda
Address: Atwood Ks 67730

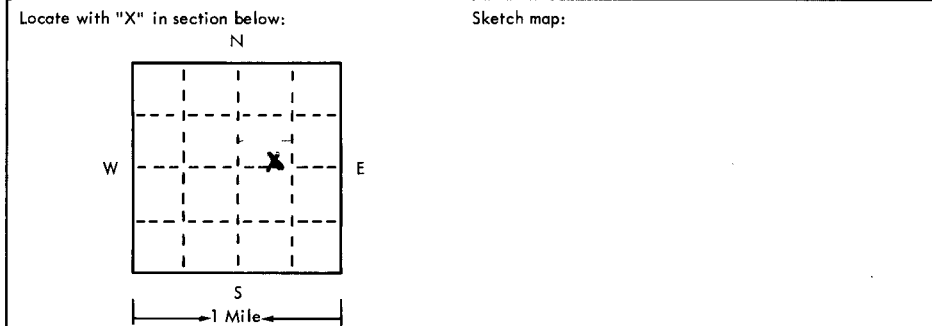

4 Well depth: 237 ft. Date of completion 9/75
Well diameter 30 in.
5 Cable tool Rotary Driven Dug
 Hollow rod Jetted Bored Reverse rotary
6 Use: Domestic Public supply Industry
 Irrigation Air conditioning Commercial
 Test well
7 Casing: Material Steel Height: above/below
Threaded Welded Surface 12 in.
Diam. 16 in. Weight 32 lbs./ft. 1
16 in. to 237 ft. depth Drive shoe? Yes No
 in. to ft. depth

2	Type and color of material	From	To
	<u>top soil & clay</u>	<u>0</u>	<u>180</u>
	<u>10' loose porous rock</u>	<u>180</u>	<u>190</u>
	<u>10' loose porous rock</u>	<u>190</u>	<u>200</u>
	<u>10' loose porous rock</u>	<u>200</u>	<u>210</u>
	<u>5' porous rock - strips of clay 5' porous rock</u>	<u>210</u>	<u>220</u>
	<u>10' gravel</u>	<u>220</u>	<u>230</u>
	<u>2' gravel 5' shale</u>	<u>230</u>	<u>237</u>

8 Screen: Manufacturer WA Brown Enterprises
Type free flow Dia. 16"
Slot/gauze Length 40
Set between 197 ft. and 237 ft.
Fittings: 3/4
Gravel pack Yes No Size range of material
9 Static water level: 180 ft. below land surface Date 9/75
10 Pumping level below land surfaces:
230 ft. after 10 hrs. pumping 240 g.p.m.
 ft. after hrs. pumping g.p.m.
Estimated maximum yield 240 g.p.m.
11 Water sample submitted:
 Yes No Date
12 Well head completion:
 Pitless adapter Inches above grade 12
13 Well grouted? Yes No Buddled clay
 Neat cement Bentonite
Depth: From 0 ft. to 10 ft.
14 Nearest source of possible contamination:
ft. Direction None Type
Well disinfected upon completion? Yes No
15 Pump: Not installed
Manufacturer's name Donalds
Model number 250 HP 2.5 Volts 440
Length of drop pipe 230 ft. capacity 240 g.m.p.
Type:
 Submersible Turbine
 Jet Reciprocating
 Centrifugal Other

16 Remarks: elevation

Topography:
 Hill
 Slope
 Upland
 Valley

17 Water well contractor's certification:
This well was drilled under my jurisdiction and this report is true to the best of my knowledge and belief.
Jack Bone Drilling 1975
Business name Donalds License No.
Address
Signed Jack Bone Date 4/76
Authorized representative

3-33W-34 SE-SW-NE