


WATER WELL PLUGGING RECORD Form WWC-5P KSA 82a-1212 ID NO. 301

1 **LOCATION OF WATER WELL:** Fraction SE 1/4 NE 1/4 SW 1/4 NW 1/4 Section Number 31 Township Number T 3 S Range Number 33 E W
 County: Rawlins

Street/Rural Address of Well Location; if unknown, distance & direction from nearest town or intersection: If at owner's address, check here
Global Positioning Systems (GPS) information:
 Latitude: 39.75060 (in decimal degrees)
 Longitude: 101.07075 (in decimal degrees)
 Elevation: _____
 Horizontal Datum: WGS84, NAD83, NAD27
 Collection Method: _____

2 **WATER WELL OWNER:** Craig Beasley
 RR#, St. Address, Box #: 21356 Road X
 City, State ZIP Code: Ludell, KS 67744
 GPS unit (Make/Model: Garmin E Trex 10)
 Digital Map/Photo, Topographic Map, Land Survey
 Est. Accuracy: <3 m, 3-5 m, 5-15 m, > 15 m

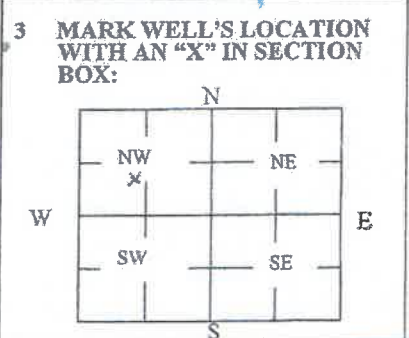

4 **DEPTH OF WELL** 160 ft.
WELL'S STATIC WATER LEVEL 143 ft.
WELL WAS USED AS:
 Domestic Public Water Supply Dewatering
 Irrigation Oil Field Water Supply Monitoring
 Feedlot Domestic (Lawn & Garden) Injection Well
 Industrial Air Conditioning Other _____
 Was a chemical/bacteriological sample submitted to Department? Yes No

5 **TYPE OF BLANK CASING USED:**
 Steel RMP (SR) Wrought Fiberglass Other (Specify below)
 PVC ABS Asbestos-Cement Concrete Tile
 Blank casing diameter 5 in. Was casing pulled? Yes No If yes, how much 48'
 Casing height above or (below) land surface 48' in.

6 **GROUT PLUG MATERIAL:** Neat cement Cement grout Bentonite Other _____
 Grout Plug Intervals: From 143 ft. to 135 ft., From 10 ft. to 5 ft., From 5 ft. to 4 ft.
Bentonite Bentonite Cement Grout
 What is the nearest source of possible contamination:
 Septic tank Seepage pit Fuel storage Other (specify below)
 Sewer lines Pit privy Fertilizer storage
 Watertight sewer lines Sewage lagoon Insecticide storage
 Lateral lines Feedyard Abandoned water well
 Cess pool Livestock pens Oil well/Gas well
 Direction from well? All
 How many feet? 1'

FROM	TO	PLUGGING MATERIALS	FROM	TO	PLUGGING MATERIALS
140	143	Washed Sand			
143	135	Bentonite			
135	10	Clay			
10	5	Bentonite			
5	4	Cement Grout			
4	0	Compacted Clay + Topsoil			

7 **CONTRACTOR'S OR LANDOWNER'S CERTIFICATION:** This water well was plugged under my jurisdiction and was completed on (mo/day/year) 5-10-18 and this record is true to the best of my knowledge and belief. Kansas Water Well Contractor's License No. 6663. This Water Well Record was completed on (mo/day/year) 5-14-18 under the business name of Brend Pump & Supply by (signature) [Signature]

Send one white copy to Kansas Department of Health & Environment, Geology Section, 1000 SW Jackson Street, Ste. 420, Topeka, KS 66612-1367. Send one copy to WATER WELL OWNER and retain one for your records.
 Visit us at <http://www.kdheks.gov/waterwell/index.html> Telephone 785-296-5524.