

WATER WELL RECORD Form WWC-5


Division of Water Resources App. No.

Well ID MW-10

Original Record Correction Change in Well Use

1 LOCATION OF WATER WELL: County: Rawlins Fraction SE 1/4 SW 1/4 SW 1/4 SE 1/4 Section Number 5 Township Number T 3 S Range Number R 33 E W

2 WELL OWNER: Last Name: First: Street or Rural Address where well is located (if unknown, distance and direction from nearest town or intersection): If at owner's address, check here: 34' E of N 2nd, U'N of Lake Rd, Atwood

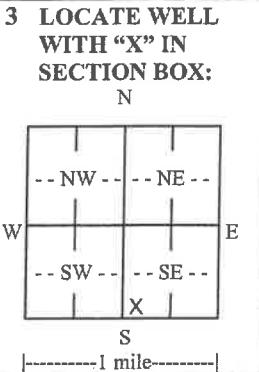

3 LOCATE WELL WITH 'X' IN SECTION BOX: N W E S 1 mile
4 DEPTH OF COMPLETED WELL: 26 ft. Depth(s) Groundwater Encountered: 1) 26 ft. 2) 3) 4) Dry Well
WELL'S STATIC WATER LEVEL: 5.60 ft. below land surface, measured on (mo-day-yr) 7/11/19
Pump test data: Well water was 8.25 hours pumping after... gpm
Well water was 26 ft. after... hours pumping after... gpm
Estimated Yield: gpm
Bore Hole Diameter: 8.25 in. to 26 in. to ft.

5 Latitude: 39.81397 (decimal degrees) Longitude: 101.04472 (decimal degrees) Horizontal Datum: WGS 84 NAD 83 NAD 27 Source for Latitude/Longitude: GPS (unit make/model: EPOCH (WAAS enabled? Yes No) Land Survey Topographic Map Online Mapper
6 Elevation: 2842.74 ft. Ground Level TOC Source: Land Survey GPS Topographic Map Other

7 WELL WATER TO BE USED AS: 1. Domestic: Household Lawn & Garden Livestock Irrigation Feedlot Industrial 2. Public Water Supply: well ID 3. Dewatering: how many wells? 4. Aquifer Recharge: well ID 5. Monitoring: well ID MW-10 6. Environmental Remediation: well ID Air Sparge Soil Vapor Extraction Recovery Injection 7. Oil Field Water Supply: lease 8. Test Hole: well ID Cased Uncased Geotechnical 9. Geothermal: how many bores? a) Closed Loop Horizontal Vertical b) Open Loop Surface Discharge Inj. of Water 10. Other (specify):

Was a chemical/bacteriological sample submitted to KDHE? Yes No If yes, date sample was submitted: Water well disinfected? Yes No

8 TYPE OF CASING USED: Steel PVC Other CASING JOINTS: Glued Clamped Welded Threaded Casing diameter 2 in. to 6 ft., Diameter in. to ft., Diameter in. to ft. Casing height above land surface 4 in. Weight lbs./ft. Wall thickness or gauge No. Sch 40
TYPE OF SCREEN OR PERFORATION MATERIAL: Steel Stainless Steel Fiberglass PVC Other (Specify) Brass Galvanized Steel Concrete tile None used (open hole)
SCREEN OR PERFORATION OPENINGS ARE: Continuous Slot Mill Slot Gauze Wrapped Torch Cut Drilled Holes Other (Specify) Louvered Shutter Key Punched Wire Wrapped Saw Cut None (Open Hole)
SCREEN-PERFORATED INTERVALS: From 6 ft. to 26 ft., From ft. to ft., From ft. to ft. GRAVEL PACK INTERVALS: From 4 ft. to 26 ft., From ft. to ft., From ft. to ft.

9 GROUT MATERIAL: Neat cement Cement grout Bentonite Other Grout Intervals: From 1 ft. to 4 ft., From ft. to ft., From ft. to ft. Nearest source of possible contamination: Septic Tank Lateral Lines Pit Privy Livestock Pens Insecticide Storage Sewer Lines Cess Pool Sewage Lagoon Fuel Storage Abandoned Water Well Watertight Sewer Lines Seepage Pit Feedyard Fertilizer Storage Oil Well/Gas Well Other (Specify) Direction from well? Distance from well? ft.

Table with 6 columns: 10 FROM, TO, LITHOLOGIC LOG, FROM, TO, LITHO. LOG (cont.) or PLUGGING INTERVALS. Rows: 0-0.5 Top soil/grass, 0.5-15 Clayey silt, 15-26 Silty Clay

Notes: Atwood 66; KDHE project code: U6-077-14735

11 CONTRACTOR'S OR LANDOWNER'S CERTIFICATION: This water well was constructed, reconstructed, or plugged under my jurisdiction and was completed on (mo-day-year) 7/11/19 and this record is true to the best of my knowledge and belief. Kansas Water Well Contractor's License No. 881 This Water Well Record was completed on (mo-day-year) 8/27/19 under the business name of Woofter Pump & Well. Signature Lane Shepard