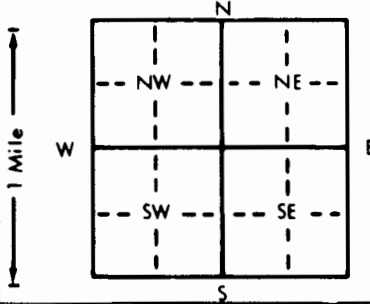


1 LOCATION OF WATER WELL: Fraction NW 1/4 SW 1/4 NW 1/4 Section Number 5 Township Number T 3 S Range Number R 35 EW
 County: Rawlins
 Distance and direction from nearest town or city street address of well if located within city?

5.6 miles NE of McDonald KS

2 WATER WELL OWNER: Ralph & Vince Pochop Trust
 RR#, St. Address, Box #: RR#2 Box 100 Board of Agriculture, Division of Water Resources
 City, State, ZIP Code: Atwood, KS 67730 Application Number:

3 LOCATE WELL'S LOCATION WITH AN "X" IN SECTION BOX:  4 DEPTH OF COMPLETED WELL: 269 ft. ELEVATION: _____ ft.
 Depth(s) Groundwater Encountered 1. _____ ft. 2. _____ ft. 3. _____ ft.
 WELL'S STATIC WATER LEVEL 131 ft. below land surface measured on mo/day/yr
 Pump test data: Well water was _____ ft. after _____ hours pumping _____ gpm
 Est. Yield 10 gpm: Well water was _____ ft. after _____ hours pumping _____ gpm
 Bore Hole Diameter 8.75 in. to _____ ft., and _____ in. to _____ ft.
 WELL WATER TO BE USED AS: 5 Public water supply 8 Air conditioning 11 Injection well
 1 Domestic 3 Feedlot 6 Oil field water supply 9 Dewatering 12 Other (Specify below)
 2 Irrigation 4 Industrial 7 Lawn and garden only 10 Monitoring well livestock
 Was a chemical/bacteriological sample submitted to Department? Yes _____ No X; If yes, mo/day/yr sample was submitted _____
 Water Well Disinfected? Yes _____ No _____

5 TYPE OF BLANK CASING USED: 5 Wrought iron 8 Concrete tile CASING JOINTS Glued Clamped
 1 Steel 3 RMP (SR) 6 Asbestos-Cement 9 Other (specify below) Welded
2 PVC 4 ABS 7 Fiberglass Threaded
 Blank casing diameter 4" in. to _____ ft., Dia _____ in. to _____ ft., Dia _____ in. to _____ ft.
 Casing height above land surface _____ in., weight _____ lbs./ft. Wall thickness or gauge No. _____
 TYPE OF SCREEN OR PERFORATION MATERIAL: 7 PVC 10 Asbestos-cement
 1 Steel 3 Stainless steel 5 Fiberglass 8 RMP (SR) 11 Other (specify) _____
 2 Brass 4 Galvanized steel 6 Concrete tile 9 ABS 12 None used (open hole)
 SCREEN OR PERFORATION OPENINGS ARE: 5 Gauzed wrapped 8 Saw cut 11 None (open hole)
 1 Continuous slot 3 Mill slot 6 Wire wrapped 9 Drilled holes
 2 Louvered shutter 4 Key punched 7 Torch cut 10 Other (specify) _____
 SCREEN-PERFORATED INTERVALS: From 24.9 ft. to 26.9 ft., From _____ ft. to _____ ft.
 From _____ ft. to _____ ft., From _____ ft. to _____ ft.
 GRAVEL PACK INTERVALS: From 20 ft. to 26.9 ft., From _____ ft. to _____ ft.
 From _____ ft. to _____ ft., From _____ ft. to _____ ft.

6 GROUT MATERIAL: 1 Neat cement 2 Cement grout 3 Bentonite 4 Other Other
 Grout Intervals: From 20 ft. to 0 ft., From _____ ft. to _____ ft., From _____ ft. to _____ ft.
 What is the nearest source of possible contamination:
 1 Septic tank 4 Lateral lines 7 Pit privy 10 Livestock pens 14 Abandoned water well
 2 Sewer lines 5 Cess pool 8 Sewage lagoon 11 Fuel storage 15 Oil well/Gas well
 3 Watertight sewer lines 6 Seepage pit 9 Feedyard 12 Fertilizer storage 16 Other (specify below)
 13 Insecticide storage _____
 Direction from well? _____ How many feet? _____

FROM	TO	LITHOLOGIC LOG	FROM	TO	PLUGGING INTERVALS
0	55	soil and clay	163	174	fine to coarse sand, some small gravel
55	105	sandstone, clay & lime			
105	110	sandstone & lime solid	174	178	sandstone, sandy clay & lime, some sand
110	118	sandstone, clay & lime			
118	119	lime hard	178	183	P. sandstone & lime, some sand
119	124	sandstone, clay & lime	183	199	fine to coarse sand, some small gravel & some lime
124	130	fine sand to small gravel			
130	140	sandstone, clay & lime	199	206	P. sandstone, sandy clay and lime
140	150	good P. sandstone & fine sand			
150	152	lime	206	211	good p. sandstone
152	155	fine to coarse sand & sandstone & lime	211	215	P. sandstone, clay & lime
			215	220	. sandstone, clay & lime
155	160	sandstone, clay & lime	220	225	sandstone, clay & lime
160	163	fine to coarse sand & sandy clay	225	245	good P. sandstone, sandy clay and lime

7 CONTRACTOR'S OR LANDOWNER'S CERTIFICATION: This water well was (1) constructed, (2) reconstructed, or (3) plugged under my jurisdiction and was completed on (mo/day/year) 3-3-05 and this record is true to the best of my knowledge and belief. Kansas Water Well Contractor's License No. 495 425 This Water Well Record was completed on (mo/day/yr) _____ under the business name of Burton Well Drilling by (signature) Vince P. Stutz

