


USE TYPEWRITER OR BALL POINT PEN-PRESS FIRMLY, PRINT CLEARLY.

WATER WELL RECORD
KSA 82a-1201-1215

Kansas Department of Health and Environment-Division of Environment
(Water well Contractors)
Topeka, Kansas 66620

Location of well: **Rawlins** County **Rawlins** Fraction **NW-SE-SE** Section number **3** Township number **T 3 S** Range number **R 35**

Distance and direction from nearest town or city: **1/4 mile S of Beardsley, Kansas**
3. Owner of well: **Ronnie Holub**
R.R. or street: **ATwood, Ks. 67730**
City, state, zip code: **ATwood, Ks. 67730**

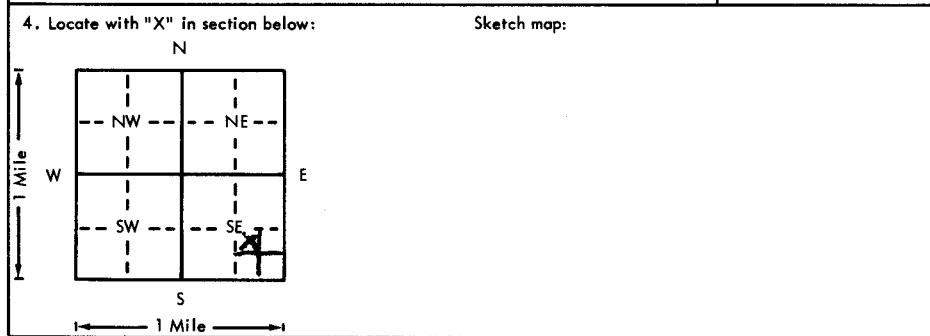

6. Bore hole dia. **8 3/8** in. Completion date **May 24 '77**
Well depth **225** ft.

7. Cable tool Rotary Driven Dug
 Hollow rod Jetted Bored Reverse rotary

8. Use: Domestic Public supply Industry
 Irrigation Air conditioning Stock
 Lawn Oil field water Other

9. Casing: Material **PVC** Height: **Above or below**
Threaded Welded Surface **12** in.
RMP PVC Weight **12.5** lbs./ft.
Dia. **5** in. to **225** ft. depth Wall Thickness: inches or
Dia. **5** in. to **225** ft. depth gage No. **4**

5. Type and color of material	From	To
Top soil dark brown	0	5
Clay - light color	5	105
Porous rock - w/strips of clay	105	135
white rock	135	142
Fine sand	142	170
Porous rock	170	194
Fine To med sand	194	210
Med sand & gravel	210	220
soap stone yellow	220	222
blue shale	222	225
(Use a second sheet if needed)		

10. Screen: Manufacturer's name **Pentless**

Type **PVC** Dia. **5"**
Slot gauze **1/8"** Length **40'**
Set between **185** ft. and **225** ft.
Gravel pack? Size range of material **1/8 to 3/8**

11. Static water level: **182** ft. below land surface Date **5-24-77**

12. Pumping level below land surfaces:
____ ft. after ____ hrs. pumping ____ g.p.m.
____ ft. after ____ hrs. pumping ____ g.p.m.
Estimated maximum yield ____ g.p.m.

13. Water sample submitted: ____ mo./day/yr.
 Yes No Date ____

14. Well head completion: **HR**
 Pitless adapter **HR** inches above grade

15. Well grouted? **yes** **quartz clay**
With: Neat cement Bentonite Concrete
(Depth) From **0** ft. to **20** ft.

16. Nearest source of possible contamination:
300 ft. Direction **west** Type **Cesspool**
Well disinfected upon completion? Yes No

17. Pump: Not installed
Manufacturer's name ____ HP ____ Volts ____
Model number ____ Length of drop pipe ____ ft. capacity ____ g.p.m.
Type: Submersible Turbine
 Jet Reciprocating
 Centrifugal Other

18. Elevation:
Topography:
 Hill
 Slope
 Upland
 Valley

19. Remarks:
Domestic - pasture

20. Water well contractor's certification:
This well was drilled under my jurisdiction and this report is true to the best of my knowledge and belief.
Jack Bone Drilling Inc
Business name License No. **197**
Address **Medonville, Ks**
Signed **Jack Bone** Date **5-25-77**
Authorized representative

T 3
R 35
S
NW SE SE
1/4 1/4 1/4