


USE TYPEWRITER OR BALL POINT PEN-PRESS FIRMLY, PRINT CLEARLY.

WATER WELL RECORD
KSA 82a-1201-1215

Kansas Department of Health and Environment-Division of Environment
(Water well Contractors)
Topeka, Kansas 66620

1. Location of well: County **Rawlins** Fraction **SE 1/4 SW 1/4 SW 1/4** Section number **6** Township number **T 3 S R 35** Range number **EW**

2. Distance and direction from nearest town or city: **Beardsley, KS** 3. Owner of well: **Wiley Gaines**
Street address of well location if in city: **3 1/2 Miles West** R.R. or street:
City, state, zip code: **Atwood, KS 67730**

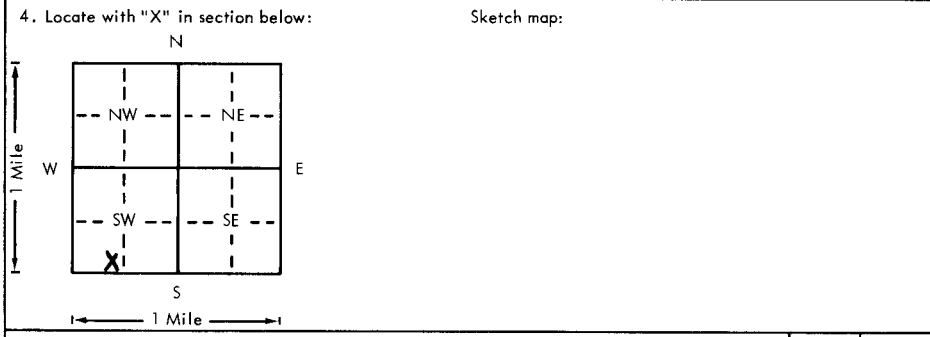

6. Bore hole dia. 36 in. Completion date _____
Well depth 310 ft. 3-30-79
7. Cable tool Rotary Driven Dug
 Hollow rod Jetted Bored Reverse rotary
8. Use: Domestic Public supply Industry
 Irrigation Air conditioning Stock
 Lawn Oil field water Other
9. Casing: Material Steel Height: Above or below
Threaded Welded Surface 12 in.
RMP PVC Weight 36 lbs./ft.
Dia. 16 in. to 310 depth Wall Thickness: inches or
Dia. in. to ft. depth gage No. 219

5. Type and color of material	From	To
Clay	0	90
White Clay & Cemented Sand	90	165
Coarse Sand, Clay & Cemented Streaks	165	181
Coarse Sand & Gravel	181	205
Fine to Coarse Sand - Clay Streaks	205	240
Fine to Med Sand	240	255
Sandstone	255	256
Fine to Medium Sand	256	284
Fine to Medium Sand & Clay Layers	284	299
Coarse Sand & Gravel & Clay Streaks	299	310
Ochre & Shale	310	---
(Use a second sheet if needed)		

10. Screen: Manufacturer's name Cook
Type Wire Wrapped Dia. 16
Slot/gauze 100 Length 10
Set between 300 ft. and 310 ft.
BrownPerf210 ft. and 300 ft.
Gravel pack? Size range of material 30% #10 to 40% #16
11. Static water level: _____ mo./day/yr.
179 ft. below land surface Date 3-31-79
12. Pumping level below land surfaces:
273 ft. after 2 hrs. pumping 700 g.p.m.
258 ft. after 1 hrs. pumping 258 g.p.m.
Estimated maximum yield 900 g.p.m.
13. Water sample submitted: _____ mo./day/yr.
 Yes No Date _____
14. Well head completion:
 Pitless adapter 12 Inches above grade
15. Well grouted? Yes
With: Neat cement Bentonite Concrete
Depth: From 0 ft. to 10 ft.
16. Nearest source of possible contamination:
5000 Direction SE Type Farmstead
Well disinfected upon completion? Yes No
17. Pump: _____ Not installed
Manufacturer's name Floway
Model number 12 DOL HP 125 Volts _____
Length of drop pipe 308 ft. capacity 800 g.p.m.
Type:
 Submersible Turbine
 Jet Reciprocating
 Centrifugal Other

18. Elevation: _____
Topography:
 Hill
 Slope
 Upland
 Valley

19. Remarks:
BROCK 310'

20. Water well contractor's certification:
This well was drilled under my jurisdiction and this report is true to the best of my knowledge and belief.
Western Well & Pump, Inc. 245
Business name License No. _____
Address **Box 852, Colby, KS 67701**
Signed O.D. Callahan Date 6-30-79
Authorized representative

T
R
S
W
Sec
1/4
1/4
1/4