


1 LOCATION OF WATER WELL: County: RAWLINS Fraction: NW 1/4 NW 1/4 SW 1/4 Section Number: 11 Township Number: T 3 S Range Number: R 35 E/W

Distance and direction from nearest town or city street address of well if located within city?
2 miles South Beardsley KANSAS

2 WATER WELL OWNER: Gordon R. Hawkins
 RR#, St. Address, Box #: RR#2
 City, State, ZIP Code: ATWOOD, KANSAS 67730
 Board of Agriculture, Division of Water Resources
 Application Number:

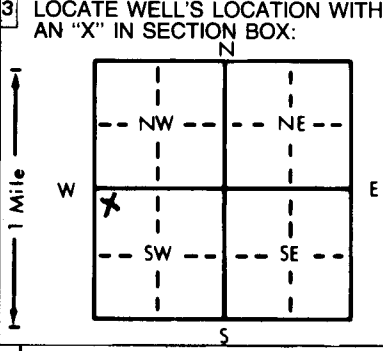

4 DEPTH OF COMPLETED WELL: 175 ft. ELEVATION:ft.
 Depth(s) Groundwater Encountered 1.ft. 2.ft. 3.ft.
 WELL'S STATIC WATER LEVEL 125 ft. below land surface measured on mo/day/yr 9-23-80
 Pump test data: Well water wasft. after hours pumping gpm
 Est. Yield gpm: Well water wasft. after hours pumping gpm
 Bore Hole Diameter: 7 in. to 175 ft., and in. toft.
 WELL WATER TO BE USED AS:
 Domestic 3 Feedlot 6 Oil field water supply 9 Dewatering 12 Other (Specify below) STOCK
 2 Irrigation 4 Industrial 7 Lawn and garden only 10 Observation well
 Was a chemical/bacteriological sample submitted to Department? Yes.....No.....; If yes, mo/day/yr sample was submitted
 Water Well Disinfected? Yes No

5 TYPE OF BLANK CASING USED:
 1 Steel 3 RMP (SR) 6 Asbestos-Cement 9 Other (specify below)
 2 PVC 4 ABS 7 Fiberglass
 Blanking diameter: 4 in. to 165 ft., Dia. in. toft., Dia. in. toft.
 Casing height above land surface: 10 in., weight 220 lbs./ft. Wall thickness or gauge No.
 TYPE OF SCREEN OR PERFORATION MATERIAL:
 1 Steel 3 Stainless steel 5 Fiberglass 8 RMP (SR) 11 Other (specify)
 2 Brass 4 Galvanized steel 6 Concrete tile 9 ABS 12 None used (open hole)
 SCREEN OR PERFORATION OPENINGS ARE:
 1 Continuous slot 3 Mill slot 6 Wire wrapped 8 Saw cut 11 None (open hole)
 2 Louvered shutter 4 Key punched 7 Torch cut 9 Drilled holes
 SCREEN-PERFORATED INTERVALS: From 165 ft. to 175 ft., Fromft. toft.
 GRAVEL PACK INTERVALS: Fromft. toft., Fromft. toft.

6 GROUT MATERIAL: 1 Neat cement 2 Cement grout Bentonite 4 Other
 Grout Intervals: From 0 ft. to 10 ft., Fromft. toft., Fromft. toft.
 What is the nearest source of possible contamination:
 1 Septic tank 4 Lateral lines 7 Pit privy 10 Livestock pens 14 Abandoned water well
 2 Sewer lines 5 Cess pool 8 Sewage lagoon 11 Fuel storage 15 Oil well/Gas well
 3 Watertight sewer lines 6 Seepage pit 9 Feedyard 12 Fertilizer storage 16 Other (specify below)
 13 Insecticide storage
 Direction from well? NORTH How many feet? 2 miles

FROM	TO	LITHOLOGIC LOG	FROM	TO	LITHOLOGIC LOG
0	28	Top Soil			
28	30	M Gravel			
30	168	Sandy Clay			
168	175	M-S Gravel			

7 CONTRACTOR'S OR LANDOWNER'S CERTIFICATION: This water well was (1) constructed, (2) reconstructed, or (3) plugged under my jurisdiction and was completed on (mo/day/year) 9-9-84 and this record is true to the best of my knowledge and belief. Kansas Water Well Contractor's License No. 214A This Water Well Record was completed on (mo/day/yr) 9-31-86 under the business name of Blue Jay Drilling Co Inc by (signature) Dean Hall Pres.
 INSTRUCTIONS: Use typewriter or ball point pen, PLEASE PRESS FIRMLY and PRINT clearly. Please fill in blanks, underline or circle the correct answers. Send top three copies to Kansas Department of Health and Environment, Division of Environment, Environmental Geology Section, Topeka, KS 66620. Send one to WATER WELL OWNER and retain one for your records.