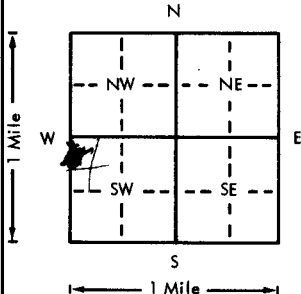


USE TYPEWRITER OR BALL  
POINT PEN-PRESS FIRMLY,  
PRINT CLEARLY.

WATER WELL RECORD  
KSA 82a-1201-1215

Kansas Department of Health and  
Environment-Division of Environment  
(Water well Contractors)  
Topeka, Kansas 66620

1. Location of well:		County <u>Rawlins</u>	Section <u>NW 1/4 SW 1/4 S4 1/4</u>	Section number <u>18</u>	Township number <u>T 3</u>	Range number <u>S R 35</u>
Distance and direction from nearest town or city: <u>4 miles east of 1/2 North M. Donald</u>		3. Owner of well: <u>Mike Leitner</u>				
Street address of well location if in city: <u>1/2 North M. Donald</u>		R.R. or street: <u>Atwood, Ka 67230</u>				
City, state, zip code: <u>Atwood, Ka 67230</u>						
4. Locate with "X" in section below:		Sketch map:		6. Bore hole dia. <u>30</u> in. Completion date <u>5-77</u> Well depth <u>300</u> ft.		
				7. Cable tool <input type="checkbox"/> Rotary <input type="checkbox"/> Driven <input type="checkbox"/> Dug <input type="checkbox"/> Hollow rod <input type="checkbox"/> Jetted <input type="checkbox"/> Bored <input checked="" type="checkbox"/> Reverse rotary		
5. Type and color of material		From	To	8. Use: Domestic <input type="checkbox"/> Public supply <input type="checkbox"/> Industry <input checked="" type="checkbox"/> Irrigation <input type="checkbox"/> Air conditioning <input type="checkbox"/> Stock <input type="checkbox"/> Lawn <input type="checkbox"/> Oil field water <input type="checkbox"/> Other		
<u>top soil - clay strips of rock</u>		<u>0</u>	<u>170</u>	9. Casing: Material <u>Steel</u> Height: Above or below Threaded <input type="checkbox"/> Welded <input checked="" type="checkbox"/> Surface <u>12</u> in. RMP <input type="checkbox"/> PVC <input type="checkbox"/> Weight <u>32</u> lbs./ft. Dia <u>16</u> in. to <u>300</u> ft. depth Wall Thickness: inches or Dia. <u>16</u> in. to <u>300</u> ft. depth gage No. <u>7</u>		
<u>strips of clay gravel</u>		<u>170</u>	<u>190</u>	10. Screens: Manufacturer's name <u>G.A. Brown Enterprises</u> Type <u>free flow</u> Dia. <u>16"</u> Slot/gauze <u>3/16</u> Length <u>40'</u> Set between <u>260</u> ft. and <u>300</u> ft. Gravel pack? <input checked="" type="checkbox"/> Size range of material <u>3/4</u>		
<u>6' gravel 4' cemented gravel strip of clay</u>		<u>190</u>	<u>200</u>	11. Static water level: <u>190</u> ft. below land surface Date <u>5-77</u>		
<u>3' gravel 3' porous rock &amp; rock</u>		<u>200</u>	<u>210</u>	12. Pumping level below land surfaces: <u>290</u> ft. after <u>6 1/2</u> hrs. pumping <u>475</u> g.p.m. ft. after <u>2</u> hrs. pumping <u>475</u> g.p.m. Estimated maximum yield <u>475</u> g.p.m.		
<u>7' porous 3' sand &amp; clay mixed</u>		<u>210</u>	<u>220</u>	13. Water sample submitted: <u>Yes</u> <input checked="" type="checkbox"/> No <input type="checkbox"/> Date <u>5-77</u>		
<u>3' rock 5' gravel 2' porous rock &amp; clay</u>		<u>220</u>	<u>230</u>	14. Well head completion: Pitless adapter <u>12</u> inches above grade		
<u>5' fine sand 5' rock</u>		<u>230</u>	<u>240</u>	15. Well grouted? <input checked="" type="checkbox"/> <u>Quilted clay</u> With: <u>Neat cement</u> Bentonite <input type="checkbox"/> Concrete <input type="checkbox"/> Depth: From <u>0</u> ft. to <u>10</u> ft.		
<u>1' rock 9' loose porous rock &amp; fine sand</u>		<u>240</u>	<u>250</u>	16. Nearest source of possible contamination: ft. <u>290</u> Direction <u>North</u> Type <u>rock</u> Well disinfected upon completion? <input type="checkbox"/> Yes <input type="checkbox"/> No		
<u>10' fine sand</u>		<u>250</u>	<u>260</u>	17. Pump: Not installed Manufacturer's name <u>Grundfos</u> Model number <u>295</u> HP <u>475</u> Volts <u>475</u> Length of drop pipe <u>295</u> ft. capacity <u>475</u> g.p.m. Type: <input type="checkbox"/> Submersible <input checked="" type="checkbox"/> Turbine <input type="checkbox"/> Jet <input type="checkbox"/> Reciprocating <input type="checkbox"/> Centrifugal <input type="checkbox"/> Other		
<u>4' fine sand 6' rock &amp; clay</u>		<u>260</u>	<u>270</u>	20. Water well contractor's certification: This well was drilled under my jurisdiction and this report is true to the best of my knowledge and belief. <u>Jack Poore</u> <u>Drilling</u> <u>1977</u> Business name <u>McDonald</u> License No. <u>67245</u> Address <u>Ka 67245</u> Signed <u>Jack Poore</u> Date <u>5-77</u> Authorized representative		
<u>6' fine sand 4' clay &amp; cavin clay</u>		<u>270</u>	<u>280</u>			
<u>10 clay - little porous rock</u>		<u>280</u>	<u>290</u>			
<u>40' clay little fine sand</u>		<u>290</u>	<u>300</u>			
(Use a second sheet if needed)						
18. Elevation:		19. Remarks:				
Topography: <input type="checkbox"/> Hill <input type="checkbox"/> Slope <input checked="" type="checkbox"/> Upland <input type="checkbox"/> Valley		<u>Irrigation</u> <u>Gated pipe</u>				