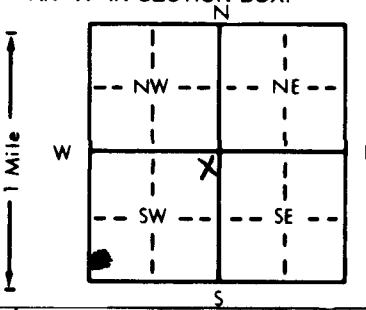


1 LOCATION OF WATER WELL: County: <u>Rawlins</u>		Fraction <u>NE</u> <u>NE</u> <u>SW</u> <u>1/4</u> <u>1/4</u> <u>1/4</u>		Section Number <u>22</u>	Township Number T <u>3</u> S	Range Number R <u>35</u> <u>EW</u>	
Distance and direction from nearest town or city street address of well if located within city? <u>9 Mi. W 3/4 M. South of Beardsley of a wood</u> <u>2 1/2 South Beardsley</u>	
2 WATER WELL OWNER: <u>Bob Binning</u> RR#, St. Address, Box # : <u>Rt. 2</u> City, State, ZIP Code : <u>McDonald, Ks. 67745</u> Board of Agriculture, Division of Water Resources Application Number:	
3 LOCATE WELL'S LOCATION WITH AN "X" IN SECTION BOX: <div style="text-align: center;"></div>		4 DEPTH OF COMPLETED WELL <u>147</u> ft. ELEVATION: Depth(s) Groundwater Encountered 1. _____ ft. 2. _____ ft. 3. _____ ft. WELL'S STATIC WATER LEVEL <u>106</u> ft. below land surface measured on mo/day/yr <u>3-11-89</u> Pump test data: Well water was _____ ft. after _____ hours pumping _____ gpm Est. Yield _____ gpm: Well water was _____ ft. after _____ hours pumping _____ gpm Bore Hole Diameter <u>9</u> in. to <u>147</u> ft., and _____ in. to _____ ft. WELL WATER TO BE USED AS: 5 Public water supply 8 Air conditioning 11 Injection well 1 Domestic 3 Feedlot 6 Oil field water supply 9 Dewatering 12 Other (Specify below) 2 Irrigation 4 Industrial 7 Lawn and garden only 10 Monitoring well Was a chemical/bacteriological sample submitted to Department? Yes _____ No <u>X</u> _____; If yes, mo/day/yr sample was sub- mitted _____ Water Well Disinfected? Yes <u>X</u> No _____	
5 TYPE OF BLANK CASING USED: 1 Steel 3 RMP (SR) 5 Wrought iron 8 Concrete tile CASING JOINTS: Glued <u>X</u> Clamped _____ 2 PVC 4 ABS 6 Asbestos-Cement 9 Other (specify below) Welded _____ 7 Fiberglass Threaded _____ Blank casing diameter <u>4 1/2</u> in. to <u>127</u> ft. Dia _____ in. to _____ ft. Dia _____ in. to _____ ft. Casing height above land surface <u>12</u> in., weight <u>0.238</u> lbs./ft. Wall thickness or gauge No. <u>0.248</u> TYPE OF SCREEN OR PERFORATION MATERIAL: 1 Steel 3 Stainless steel 5 Fiberglass 7 PVC 10 Asbestos-cement 2 Brass 4 Galvanized steel 6 Concrete tile 8 RMP (SR) 11 Other (specify) _____ 12 None used (open hole) SCREEN OR PERFORATION OPENINGS ARE: 1 Continuous slot 3 Mill slot 5 Gauzed wrapped 8 Saw cut 11 None (open hole) 2 Louvered shutter 4 Key punched 6 Wire wrapped 9 Drilled holes 7 Torch cut 10 Other (specify) _____ SCREEN-PERFORATED INTERVALS: From <u>127</u> ft. to <u>147</u> ft., From _____ ft. to _____ ft. From _____ ft. to _____ ft., From _____ ft. to _____ ft. GRAVEL PACK INTERVALS: From <u>20</u> ft. to <u>127</u> ft., From _____ ft. to _____ ft. From _____ ft. to _____ ft., From _____ ft. to _____ ft.	
6 GROUT MATERIAL: 1 Neat cement 2 <u>Cement grout</u> 3 Bentonite 4 Other _____ Grout Intervals: From <u>0</u> ft. to <u>20</u> ft., From _____ ft. to _____ ft., From _____ ft. to _____ ft. What is the nearest source of possible contamination: 1 Septic tank 4 Lateral lines 7 Pit privy 10 Livestock pens 14 <u>Abandoned water well</u> 2 Sewer lines 5 Cess pool 8 Sewage lagoon 11 Fuel storage 15 Oil well/Gas well 3 Watertight sewer lines 6 Seepage pit 9 Feedyard 12 Fertilizer storage 16 Other (specify below) _____ 13 Insecticide storage Direction from well? <u>South</u> How many feet? <u>150</u>	
<table border="1" style="width:100%; border-collapse: collapse;"><thead><tr><th>FROM</th><th>TO</th><th>LITHOLOGIC LOG</th><th>FROM</th><th>TO</th><th>PLUGGING INTERVALS</th></tr></thead><tbody><tr><td>0</td><td>3</td><td>Surface</td><td>139</td><td>145</td><td>Ochre</td></tr><tr><td>3</td><td>53</td><td>Clay</td><td>145</td><td>147</td><td>Shale</td></tr><tr><td>53</td><td>55</td><td>Med sand</td><td></td><td></td><td></td></tr><tr><td>55</td><td>70</td><td>Caliche</td><td></td><td></td><td></td></tr><tr><td>70</td><td>87</td><td>Med. sand</td><td></td><td></td><td></td></tr><tr><td>87</td><td>89</td><td>Caliche</td><td></td><td></td><td></td></tr><tr><td>89</td><td>91</td><td>Fine sand</td><td></td><td></td><td></td></tr><tr><td>91</td><td>99</td><td>Clay</td><td></td><td></td><td></td></tr><tr><td>99</td><td>104</td><td>Med. sand</td><td></td><td></td><td></td></tr><tr><td>104</td><td>106</td><td>Caliche & fine/med sand streak</td><td></td><td></td><td></td></tr><tr><td>106</td><td>113</td><td>Clay</td><td></td><td></td><td></td></tr><tr><td>113</td><td>115</td><td>Caliche</td><td></td><td></td><td></td></tr><tr><td>115</td><td>117</td><td>Med sand</td><td></td><td></td><td></td></tr><tr><td>117</td><td>135</td><td>Sandstone</td><td></td><td></td><td></td></tr><tr><td>135</td><td>139</td><td>Med. sand</td><td></td><td></td><td></td></tr>
7 CONTRACTOR'S OR LANDOWNER'S CERTIFICATION: This water well was (1) <u>constructed</u> , (2) reconstructed, or (3) plugged under my jurisdiction and was completed on (mo/day/year) <u>3-11-89</u> and this record is true to the best of my knowledge and belief. Kansas Water Well Contractor's License No. <u>394</u> This Water Well Record was completed on (mo/day/yr) <u>3-15-89</u> under the business name of <u>Woofter Pump & Well</u> by (signature) <u>Walter Woofter</u>	