

WATER WELL RECORD

Form WWC-5

1320518

Division of Water Resources App. No.


Well ID

Well ID

Original Record Correction Change in Well Use

1 LOCATION OF WATER WELL: County, Fraction, Section Number, Township Number, Range Number

2 WELL OWNER: Last Name, Business, Address, City, State, ZIP, Street or Rural Address

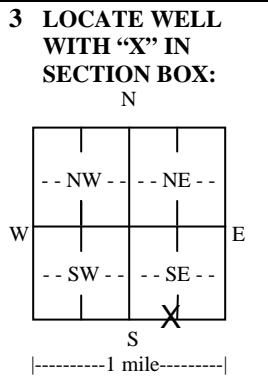

4 DEPTH OF COMPLETED WELL: Depth(s) Groundwater Encountered, WELL'S STATIC WATER LEVEL, Pump test data, Estimated Yield, Bore Hole Diameter

5 Latitude, Longitude, Datum, Source for Latitude/Longitude, GPS, Land Survey, Topographic Map, Online Mapper

6 Elevation, Source, Other

7 WELL WATER TO BE USED AS: Domestic, Irrigation, Industrial, Public Water Supply, Dewatering, Aquifer Recharge, Monitoring, Environmental Remediation, Oil Field Water Supply, Test Hole, Geothermal, Other

Was a chemical/bacteriological sample submitted to KDHE? Water well disinfected?

8 TYPE OF CASING USED: Steel, PVC, Other, CASING JOINTS, Casing diameter, Casing height, TYPE OF SCREEN OR PERFORATION MATERIAL, SCREEN OR PERFORATION OPENINGS ARE, SCREEN-PERFORATED INTERVALS, GRAVEL PACK INTERVALS

9 GROUT MATERIAL: Neat cement, Cement grout, Bentonite, Other, Grout Intervals, Nearest source of possible contamination: Septic Tank, Sewer Lines, Watertight Sewer Lines, Lateral Lines, Cess Pool, Seepage Pit, Pit Privy, Sewage Lagoon, Feedyard, Livestock Pens, Fuel Storage, Fertilizer Storage, Insecticide Storage, Abandoned Water Well, Oil Well/Gas Well

Table with columns: FROM, TO, LITHOLOGIC LOG, FROM, TO, LITHO. LOG (cont.) or PLUGGING INTERVALS. Includes a Notes section.

11 CONTRACTOR'S OR LANDOWNER'S CERTIFICATION: This water well was constructed, reconstructed, or plugged under my jurisdiction...