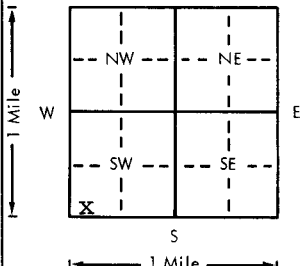


USE TYPEWRITER OR BALL
POINT PEN-PRESS FIRMLY,
PRINT CLEARLY.

WATER WELL RECORD
KSA 82a-1201-1215

Kansas Department of Health and
Environment-Division of Environment
(Water well Contractors)
Topeka, Kansas 66620

| | | | | | | | |
|---|--|--|--|--------------------------|--|--------------------------|------------|
| 2. Distance and direction from nearest town or city: <u>1 1/2 miles south</u> Street address of well location if in city: | | | 3. Owner of well: <u>DeRoy Hubbard</u> R.R. or street: <u>Route # 1</u> City, state, zip code: <u>McDonald, Kansas 67745</u> | | | | |
| 4. Locate with "X" in section below: | | | Sketch map: | | | | |
|  | | | | | | | |
| 5. Type and color of material | | | From | To | 6. Bore hole dia. <u>36</u> in. Completion date _____ Well depth <u>289</u> ft. <u>3-22-79</u> | | |
| Clay | | | 0 | 103 | 7. Cable tool _____ Rotary _____ Driven _____ Dug _____ Hollow rod _____ Jetted _____ Bored <u>X</u> Reverse rotary | | |
| Sand & gravel | | | 103 | 116 | 8. Use: _____ Domestic _____ Public supply _____ Industry _____ <u>X</u> Irrigation _____ Air conditioning _____ Stock _____ Lawn _____ Oil field water _____ Other _____ | | |
| Clay | | | 116 | 124 | 9. Casing: Material <u>Steel</u> Height: Above or below _____ Threaded _____ Welded <u>X</u> Surface <u>12</u> in. RMP _____ PVC _____ Weight <u>36.91</u> lbs./ft. Dia. <u>16</u> in. to <u>289</u> ft. depth Wall Thickness: inches or _____ Dia. _____ in. to _____ ft. depth gage No. <u>219</u> | | |
| Sand & gravel | | | 124 | 136 | 10. Screen: Manufacturer's name <u>Cook</u> <u>Wire wrapped</u> Type _____ Dia. <u>16</u> Slot/gauze <u>100</u> Length <u>10'</u> Set between <u>279</u> ft. and <u>289</u> ft. <u>Brown Perf 219</u> ft. and <u>279</u> ft. Gravel pack? <u>yes</u> Size range of material <u>50% #1, 50% #4 x 5/8</u> | | |
| Clay & sandstone streaks | | | 136 | 159 | 11. Static water level: _____ mo./day/yr. <u>177</u> ft. below land surface Date <u>3-25-79</u> | | |
| Coarse sand & gravel | | | 159 | 191 | 12. Pumping level below land surfaces: <u>280</u> ft. after <u>2</u> hrs. pumping <u>433</u> g.p.m. _____ ft. after _____ hrs. pumping _____ g.p.m. Estimated maximum yield <u>433</u> g.p.m. | | |
| Sandstone (hard) | | | 191 | 196 | 13. Water sample submitted: _____ mo./day/yr. _____ Yes <u>X</u> No Date _____ | | |
| Coarse sand & gravel | | | 196 | 201 | 14. Well head completion: _____ Pitless adapter <u>12</u> inches above grade | | |
| Clay & sandstone streaks | | | 201 | 215 | 15. Well grouted? <u>X</u> <u>yes</u> With: _____ Neat cement _____ Bentonite <u>X</u> Concrete _____ Depth: From _____ ft. to <u>10</u> ft. | | |
| Medium coarse sand & clay mixed | | | 215 | 225 | 16. Nearest source of possible contamination: ft. <u>5300</u> Direction <u>NNW</u> Type <u>Farmstead</u> Well disinfected upon completion? _____ Yes <u>X</u> No | | |
| Clay & sandstone | | | 225 | 249 | 17. Pump: _____ Not installed Manufacturer's name <u>Floway</u> Model number <u>10LKN</u> HP <u>60</u> Volts _____ Length of drop pipe <u>287</u> ft. capacity <u>400</u> g.p.m. Type: _____ Submersible _____ <u>X</u> Turbine _____ Jet _____ Reciprocating _____ Centrifugal _____ Other | | |
| Ochre & shale | | | 281 | 284 | 20. Water well contractor's certification: This well was drilled under my jurisdiction and this report is true to the best of my knowledge and belief. <u>Western Well & Pump</u> <u>245</u> Business name _____ License No. _____ Address <u>P.O. Box 852, Colby KS 67701</u> Signed <u>[Signature]</u> Date <u>5-22-79</u> Authorized representative | | |
| 18. Elevation: | | | 19. Remarks: | | | | |
| Topography: _____ Hill _____ Slope <u>X</u> Upland _____ Valley | | | (Use a second sheet if needed) | | | | |