WATER WELL RECORD Form WWC-5 KSA 82a-1212

1 LOCATION OF WATER WELL: County: Rawlins | Fraction: SW ¼ NE ¼ SW ¼ | Section Number: 28 | Township Number: T 3 S | Range Number: R 36 E(W)

Distance and direction from nearest town or city street address of well if located within city?
5 mi So. ¾ west of McDonald KS.

2 WATER WELL OWNER: Rodney Johnson
RR#, St. Address, Box # : Box 213
City, State, ZIP Code : McDonald KS. 67745

Board of Agriculture, Division of Water Resources
Application Number:

3 LOCATE WELL'S LOCATION WITH AN "X" IN SECTION BOX:

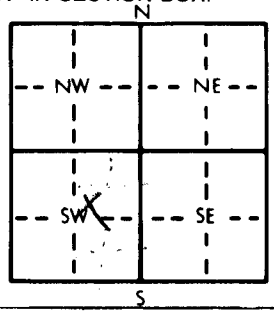

4 DEPTH OF COMPLETED WELL 166 ft. ELEVATION: 3350
Depth(s) Groundwater Encountered 1. 84 ft. 2. ft. 3. ft.
WELL'S STATIC WATER LEVEL 84 ft. below land surface measured on mo/day/yr 4-30-91
Pump test data: Well water was ft. after hours pumping gpm
Est. Yield 10 gpm: Well water was ft. after hours pumping gpm
Bore Hole Diameter 8 in. to 166 ft., and in. to ft.
WELL WATER TO BE USED AS: 5 Public water supply 8 Air conditioning 11 Injection well
1 Domestic 3 Feedlot 6 Oil field water supply 9 Dewatering 12 Other (Specify below)
2 Irrigation 4 Industrial 7 Lawn and garden only 10 Monitoring well Stock
Was a chemical/bacteriological sample submitted to Department? Yes No X; If yes, mo/day/yr sample was submitted
Water Well Disinfected? Yes X No

5 TYPE OF BLANK CASING USED: 5 Wrought iron 8 Concrete tile CASING JOINTS: Glued X Clamped
1 Steel 3 RMP (SR) 6 Asbestos-Cement 9 Other (specify below) Welded
2 (PVC) 4 ABS 7 Fiberglass Threaded
Blank casing diameter 5 in. to 156 ft., Dia in. to ft., Dia in. to ft.
Casing height above land surface 18 in., weight 2.81 lbs./ft. Wall thickness or gauge No. SDR21

TYPE OF SCREEN OR PERFORATION MATERIAL: 7 (PVC) 10 Asbestos-cement
1 Steel 3 Stainless steel 5 Fiberglass 8 RMP (SR) 11 Other (specify)
2 Brass 4 Galvanized steel 6 Concrete tile 9 ABS 12 None used (open hole)

SCREEN OR PERFORATION OPENINGS ARE: 5 Gauzed wrapped 8 Saw cut 11 None (open hole)
1 Continuous slot (3 Mill slot) 6 Wire wrapped 9 Drilled holes
2 Louvered shutter 4 Key punched 7 Torch cut 10 Other (specify)

SCREEN-PERFORATED INTERVALS: From 156 ft. to 166 ft., From ft. to ft.
From ft. to ft., From ft. to ft.
GRAVEL PACK INTERVALS: From 28 ft. to 166 ft., From ft. to ft.
From ft. to ft., From ft. to ft.

6 GROUT MATERIAL: 1 Neat cement 2 Cement grout (3 Bentonite) 4 Other clay
Grout Intervals: From 28 ft. to 21 ft., From 21 ft. to 0 ft., From ft. to ft.

What is the nearest source of possible contamination:
1 Septic tank 4 Lateral lines 7 Pit privy 10 Livestock pens 14 Abandoned water well
2 Sewer lines 5 Cess pool 8 Sewage lagoon 11 Fuel storage 15 Oil well/Gas well
3 Watertight sewer lines 6 Seepage pit 9 Feedyard 12 Fertilizer storage 16 Other (specify below)
13 Insecticide storage N.A. Pasture
Direction from well? How many feet?

FROM	TO	LITHOLOGIC LOG	FROM	TO	PLUGGING INTERVALS
0	2	Top Soil			
2	68	Clay			
68	72	Sand & Gravel			
72	135	Sand - Clay layers			
135	141	Rock Hard			
141	166	Sand & Gravel with layers of Rock			
166	170	Shale			

7 CONTRACTOR'S OR LANDOWNER'S CERTIFICATION: This water well was (1) (constructed), (2) reconstructed, or (3) plugged under my jurisdiction and was completed on (mo/day/year) 4-30-91 and this record is true to the best of my knowledge and belief. Kansas Water Well Contractor's License No. 184 This Water Well Record was completed on (mo/day/yr) 5-17-91
under the business name of Schoen Rigge Drilling Inc by (signature)

INSTRUCTIONS: Use typewriter or ball point pen. *PLEASE PRESS FIRMLY* and *PRINT* clearly. Please fill in blanks, underline or circle the correct answers. Send top three copies to Kansas Department of Health and Environment, Bureau of Water Protection, Topeka, Kansas 66620-7320. Telephone: 913-296-5514. Send one to WATER WELL OWNER and retain one for your records.

OFFICE USE ONLY T R E/W SEC. ¼ ¼ ¼