


1 LOCATION OF WATER WELL:	Fraction	Section Number	Township Number	Range Number
County: Rawlins	NE 1/4 SE 1/4 NE 1/4	20	T 3 S	R 36 EW

Distance and direction from nearest town or city street address of well if located within city?

in town

2 WATER WELL OWNER: DEL SERVICE	Board of Agriculture, Division of Water Resources Application Number:
RR#, St. Address, Box #: Highway 36	
City, State, ZIP Code: McDonald, KS.	

3 LOCATE WELL'S LOCATION WITH AN "X" IN SECTION BOX:	4 DEPTH OF COMPLETED WELL: 238 ft. ELEVATION:
--	--

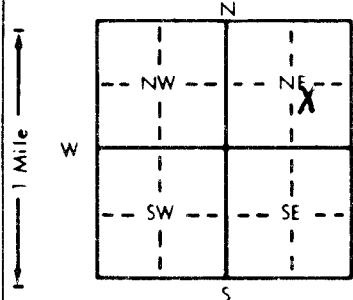

Depth(s) Groundwater Encountered	1. ft.	2. ft.	3. ft.
WELL'S STATIC WATER LEVEL	210.41 ft. below land surface measured on mo/day/yr		
Pump test data: Well water was	ft. after	hours pumping	gpm
Est. Yield	gpm	Well water was	ft. after
Bore Hole Diameter	in. to	ft. and	in. to
WELL WATER TO BE USED AS:	5 Public water supply	8 Air conditioning	11 Injection well
1 Domestic	3 Feedlot	6 Oil field water supply	9 Dewatering
2 Irrigation	4 Industrial	7 Lawn and garden only	10 Monitoring well
Was a chemical/bacteriological sample submitted to Department? Yes	No	If yes, mo/day/yr sample was submitted	
Water Well Disinfected? Yes	No		

5 TYPE OF BLANK CASING USED:	5 Wrought iron	8 Concrete tile	CASING JOINTS: Glued	Clamped
1 Steel	3 RMP (SR)	6 Asbestos-Cement	9 Other (specify below)	Welded
2 PVC	4 ABS	7 Fiberglass		Treaded
Blank casing diameter	2 in. to 200 ft., Dia			
Casing height above land surface	0 in., weight			
TYPE OF SCREEN OR PERFORATION MATERIAL:				
1 Steel	3 Stainless steel	5 Fiberglass	8 RMP (SR)	11 Other (specify)
2 Brass	4 Galvanized steel	6 Concrete tile	9 ABS	12 None used (open hole)
SCREEN OR PERFORATION OPENINGS ARE:				
1 Continuous slot	3 Mill slot	5 Gauzed wrapped	8 Saw cut	11 None (open hole)
2 Louvered shutter	4 Key punched	6 Wire wrapped	9 Drilled holes	
SCREEN-PERFORATED INTERVALS:	From 200 ft. to 230 ft.			
	From	ft. to		
GRAVEL PACK INTERVALS:	From 144 ft. to 230 ft.			
	From	ft. to		

6 GROUT MATERIAL:	1 Neat cement	2 Cement grout	3 Bentonite	4 Other
Grout Intervals:	From 0 ft. to 1.5 ft.	From 1.5 ft. to 140 ft.	From 140 ft. to 144 ft.	
What is the nearest source of possible contamination:				
1 Septic tank	4 Lateral lines	7 Pit privy	10 Livestock pens	14 Abandoned water well
2 Sewer lines	5 Cess pool	8 Sewage lagoon	11 Fuel storage	15 Oil well/Gas well
3 Watertight sewer lines	6 Seepage pit	9 Feedyard	12 Fertilizer storage	16 Other (specify below)
			13 Insecticide storage	

Direction from well?		How many feet?	
FROM	TO	FROM	TO
0	5.0		
5.0	130'		
130	160'		
160	238'		
LITHOLOGIC LOG		PLUGGING INTERVALS	
Topsoil, clay w/silt dark brown			
Silt w/clay, brown			
clay light tan w/silt & sand			
Sand, Med. grained w/GRAVEL			

7 CONTRACTOR'S OR LANDOWNER'S CERTIFICATION: This water well was (1) constructed, (2) reconstructed, or (3) plugged under my jurisdiction and was completed on (mo/day/year) 6-6-94 and this record is true to the best of my knowledge and belief. Kansas Water Well Contractor's License No. 138 This Water Well Record was completed on (mo/day/yr) 8/31/94 under the business name of Kansas City Testing & Inc. by (signature) <i>[Signature]</i>
--