


1 LOCATION OF WATER WELL:	Fraction	Section Number	Township Number	Range Number
County: Rawlins	NE 1/4 SE 1/4 NE 1/4	20	T 3 S	R 36 E/W

Distance and direction from nearest town or city street address of well if located within city?

in town
MW2

2 WATER WELL OWNER:	Board of Agriculture, Division of Water Resources
RR#, St. Address, Box # :	Application Number:
City, State, ZIP Code :	

3 LOCATE WELL'S LOCATION WITH AN "X" IN SECTION BOX:	4 DEPTH OF COMPLETED WELL. 230 ft. ELEVATION:
--	--

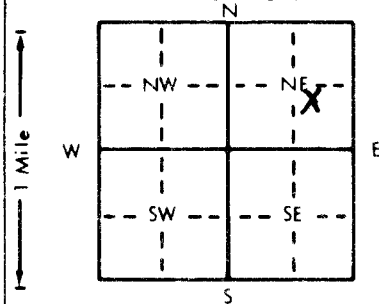

Depth(s) Groundwater Encountered 1. ft. 2. ft. 3. ft.
WELL'S STATIC WATER LEVEL 210.02 ft. below land surface measured on mo/day/yr
Pump test data: Well water was ft. after hours pumping gpm
Est. Yield gpm: Well water was ft. after hours pumping gpm
Bore Hole Diameter in. to ft. and in. to ft.
WELL WATER TO BE USED AS:
1 Domestic 3 Feedlot 6 Oil field water supply 9 Dewatering 12 Other (Specify below)
2 Irrigation 4 Industrial 7 Lawn and garden only 10 Monitoring well
Was a chemical/bacteriological sample submitted to Department? Yes No ; If yes, mo/day/yr sample was submitted
Water Well Disinfected? Yes No

5 TYPE OF BLANK CASING USED:	5 Wrought iron	8 Concrete tile	CASING JOINTS: Glued Clamped
1 Steel	6 Asbestos-Cement	9 Other (specify below)	Welded
2 PVC	7 Fiberglass		Threaded
Blank casing diameter 2 in. to 200 ft. Dia in. to ft. Dia in. to ft.			
Casing height above land surface 0 in. weight lbs./ft. Wall thickness or gauge No.			
TYPE OF SCREEN OR PERFORATION MATERIAL:	7 PVC	10 Asbestos-cement	
1 Steel	8 RMP (SR)	11 Other (specify)	
2 Brass	9 ABS	12 None used (open hole)	
4 Galvanized steel			
SCREEN OR PERFORATION OPENINGS ARE:	5 Gauzed wrapped	8 Saw cut	11 None (open hole)
1 Continuous slot	6 Wire wrapped	9 Drilled holes	
3 Mill slot	7 Torch cut	10 Other (specify)	
2 Louvered shutter			
4 Key punched			
SCREEN-PERFORATED INTERVALS: From 200 ft. to 230 ft. From ft. to ft.			
GRAVEL PACK INTERVALS: From 140 ft. to 230 ft. From ft. to ft.			

6 GROUT MATERIAL:	1 Neat cement	2 Cement grout	3 Bentonite	4 Other
Grout intervals: From 0 ft. to 1.5 ft. From 1.5 ft. to 136 ft. From 136 ft. to 140 ft.				
What is the nearest source of possible contamination:	10 Livestock pens	14 Abandoned water well		
1 Septic tank	4 Lateral lines	7 Pit privy	1 Fuel storage	15 Oil well/Gas well
2 Sewer lines	5 Cess pool	8 Sewage lagoon	12 Fertilizer storage	16 Other (specify below)
3 Watertight sewer lines	6 Seepage pit	9 Feedyard	13 Insecticide storage	
Direction from well?			How many feet?	

FROM	TO	LITHOLOGIC LOG	FROM	TO	PLUGGING INTERVALS
0	5.0	Topsoil, clay, dark brown			
5.0	120.0	silt w/clay BROWN			
120.0	160.0	clay w/sand light tan			
160.0	230.0	GRAVEL w/sand brown			
		water at 210'			

7 CONTRACTOR'S OR LANDOWNER'S CERTIFICATION: This water well was (1) constructed, (2) reconstructed, or (3) plugged under my jurisdiction and was completed on (mo/day/year) 08-24-94 6-4-94 and this record is true to the best of my knowledge and belief. Kansas
Water Well Contractor's License No. 438 This Water Well Record was completed on (mo/day/yr) 8/31/94
under the business name of Kansas City Testing & Inc. by (signature) [Signature]