CORRECTION(S) TO WATER WELL RECORD (WWC-5)
(to rectify lacking or incorrect information)

County: Cheyenne

Location listed as:	**Location changed to:**
Section-Township-Range: 28-3-38	28-3 S-38 W
Fraction (¼ ¼ ¼): SW	NW SW SW

Other changes: Initial statements:

Changed to:

Comments:

verification method: Written & legal descriptions, county ownership map, water rights records (WIMAS database), and mapping tool & aerial photos on KGS website. initials: DRB date: 6/4/2009

submitted by: Kansas Geological Survey, Data Resources Library, 1930 Constant Ave., Lawrence, KS 66047-3726
to: Kansas Dept of Health & Environment, Bureau of Water, 1000 SW Jackson, Suite 420, Topeka, KS 66612-1367.

USE TYPEWRITER OR BALL POINT PEN-PRESS FIRMLY, PRINT CLEARLY.

~~BF~~ CCB

WATER WELL RECORD
KSA 82a-1201-1215

T R EW sec 1/4 1/4 1/4 No.

Kansas State Dept. Of Health
(Water Well Contractors)
Forbes-Bldg. 740
Topeka, Kansas 66620

1 Location of well:	County	Township name	Fraction	Section number	Town number	Range number
	Cheyenne	Bird City	SW 1/4	28	3	38

Distance and direction from nearest town or city: 3 miles West of Bird City

Street address of well location if in city: 1/4 mile north

3 Owner of well: Jim Leach

Address: Bird City, Kansas

Locate with "X" in section below:

Sketch map:

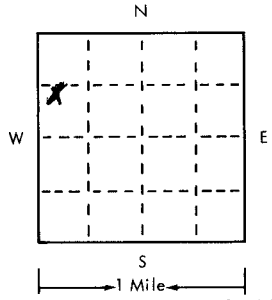

2

Type and color of material	From	To
Top soil	0	2
Yellow Clay	2	110
Brown sandy Clay	110	133
Sand + Gravel Clay	133	136
Rock	136	137
Sand + Gravel - SR Clay	137	150
Rock	150	151
Sand + Gravel - Clay	151	210
Sand + Gravel - Clay	210	215
Rock	215	217
Sand + Gravel - Clay	217	224
Rock	224	225
Sand - Clay	225	251
Rock	251	252
Sand SR Clay	252	258
Rock	258	259
Sand + Gravel - Clay	259	285
Sand Clay	285	300
Layer of hard SR	300	301
Sand Clay	301	308
Sand + Gravel - Few layers Shale	308	318
Sand	318	325
Shale (use a second sheet if needed)	325	330

4 Well depth: 325 ft. Date of completion 30 Apr 75
Well diameter 30 in.

5 ☐ Cable tool ☐ Rotary ☐ Driven ☐ Dug
☐ Hollow rod ☐ Jetted ☐ Bored ☒ Reverse rotary

6 Use: ☐ Domestic ☐ Public supply ☐ Industry
☒ Irrigation ☐ Air conditioning ☐ Commercial
☐ Test well ☐ _____

7 Casing: Material Steel Height: above/below
Threaded ☐ Welded ☒ Surface 12 in.
Diam. 16 in. to 315 ft. depth Weight 30.30 lbs./ft. L
Drive shoe? ☐ Yes ☒ No
___ in. to ___ ft. depth

8 Screen:
Manufacturer Cook
Type _____ Dia. 16"
Slot/gauze 1/8" Length 10'
Set between 315 ft. and 325 ft.
Fittings:
Gravel pack ☒ Yes ☐ No Size range of material 1/4

9 Static water level:
203 ft. below land surface Date 29 May 75

10 Pumping level below land surfaces:
___ ft. after ___ hrs. pumping ___ g.p.m.
___ ft. after ___ hrs. pumping ___ g.p.m.
Estimated maximum yield 800 g.p.m.

11 Water sample submitted:
☐ Yes ☒ No Date _____

12 Well head completion:
☐ Pitless adapter ☐ Inches above grade

13 Well grouted? ☒ Yes ☐ No
☐ Neat cement ☐ Bentonite ☒ Concrete
Depth: From 0 ft. to 10 ft.

14 Nearest source of possible contamination:
ft. None Direction _____ Type _____
Well disinfected upon completion? ☐ Yes ☒ No

15 Pump: ☐ Not installed
Manufacturer's name Western Land Roller
Model number 8" Type B HP _____ Volts _____
Length of drop pipe 300 ft. capacity ___ g.m.p.
Type:
☐ Submersible ☒ Turbine
☐ Jet ☐ Reciprocating
☐ Certrifugal ☐ Other

16 Remarks: elevation 3255'

13

Topography:
☐ Hill
☐ Slope
☒ Upland
☐ Valley

17 Water well contractor's certification:
This well was drilled under my jurisdiction and this report is true to the best of my knowledge and belief.
Schoenrock Drilling Co 184A
Business name License No.
Address Ft. Francis, KS
Signed [signature] Date 2 June 75
Authorized representative

Forward the white, blue and pink copies to the Kansas State Dept. Of Health.

Form WWC-5

677-H