


**WATER WELL PLUGGING RECORD Form WWC-5P KSA 82a-1212 ID NO.**

**1 LOCATION OF WATER WELL:** Fraction NE 1/4 20 1/4 NW 1/4 20 1/4 Section Number 28 Township Number 3 T S Range Number 39  E  W  

Street/Rural Address of Well Location; if unknown, distance & direction from nearest town or intersection: If at owner's address, check here   
**Global Positioning Systems (GPS) information:**  
 Latitude: 39.76190 (in decimal degrees)  
 Longitude: 101.71035 (in decimal degrees)  
 Elevation: \_\_\_\_\_  
 Horizontal Datum:  WGS84,  NAD83,  NAD27  
 Collection Method: \_\_\_\_\_

**2 WATER WELL OWNER:** Marvin (Wesley) Mullins  
 RR#, St. Address, Box #: 300 Kansas Ave  
 City, State ZIP Code: Wheeler, KS 67760  
 GPS unit (Make/Model: \_\_\_\_\_)  
 Digital Map/Photo,  Topographic Map,  Land Survey  
 Est. Accuracy:  < 3 m,  3-5 m,  5-15 m,  > 15 m

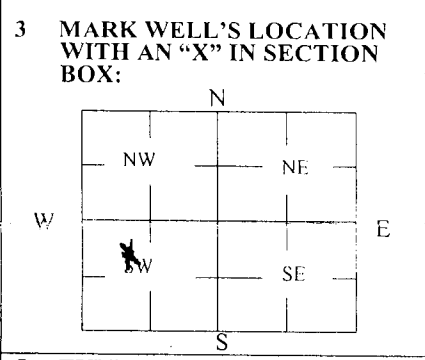

**4 DEPTH OF WELL** 210 ft.  
 WELL'S STATIC WATER LEVEL 195 ft.  
 WELL WAS USED AS:  
 Domestic  Public Water Supply  Dewatering  
 Irrigation  Oil Field Water Supply  Monitoring  
 Feedlot  Domestic (Lawn & Garden)  Injection Well  
 Industrial  Air Conditioning  Other \_\_\_\_\_  
 Was a chemical/bacteriological sample submitted to Department? Yes  No

**5 TYPE OF BLANK CASING USED:**  
 Steel  RMP (SR)  Wrought  Fiberglass  Other (Specify below)  
 PVC  ABS  Asbestos-Cement  Concrete Tile  
 Blank casing diameter 6 in. Was casing pulled? Yes  No  If yes, how much \_\_\_\_\_  
 Casing height above or below land surface 5ft in.

**6 GROUT PLUG MATERIAL:**  Neat cement  Cement grout  Bentonite  Other concrete  
 Grout Plug Intervals: From 35 ft. to 40 ft., From 185 ft. to 195 ft., From 195 ft. to 210 ft.  
 What is the nearest source of possible contamination:  
 Septic tank  Seepage pit  Fuel storage  Other (specify below)  
 Sewer lines  Pit privy  Fertilizer storage  
 Watertight sewer lines  Sewage lagoon  Insecticide storage  
 Lateral lines  Feedyard  Abandoned water well  
 Cess pool  Livestock pens  Oil well/Gas well  
 Direction from well? West  
 How many feet? 150ft

Bottom to Top

FROM	TO	PLUGGING MATERIALS	FROM	TO	PLUGGING MATERIALS
0	35	Sand			
35	40	Bentonite			
40	180	Dirt			
180	185	Bentonite			
185	190	Concrete			
190	210	Dirt			

**7 CONTRACTOR'S OR LANDOWNER'S CERTIFICATION:** This water well was plugged under my jurisdiction and was completed on (mo/day/year) 10-14-19 and this record is true to the best of my knowledge and belief. Kansas Water Well Contractor's License No. 12672. This Water Well Record was completed on (mo/day/year) 10-14-19 under the business name of Rocky McCreary Concrete & Construction (signature) Rocky McCreary