


1 LOCATION OF WATER WELL: Fraction NE 1/4 SE 1/4 NE 1/4 Section Number 18 Township Number T3 S Range Number R 4 E(W)
 County: Republic

Distance and direction from nearest town or city street address of well if located within city?
1 West Scandia 1/2 mi South on West Side

2 WATER WELL OWNER: REPUBLICAN VALLEY FEEDERS
 RR#, St. Address, Box #: RR 1 Board of Agriculture, Division of Water Resources
 City, State, ZIP Code: SCANDIA, KS 66966 Application Number:

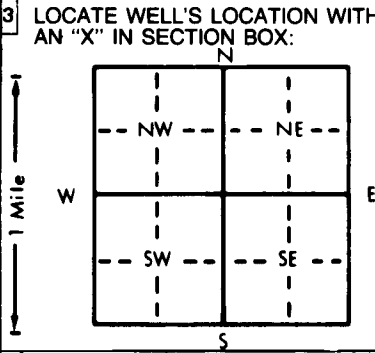

4 DEPTH OF COMPLETED WELL: 75 ft. ELEVATION:
 Depth(s) Groundwater Encountered 1. ft. 2. ft. 3. ft.
 WELL'S STATIC WATER LEVEL: 1.1 ft. below land surface measured on mo/day/yr
 Pump test data: Well water was 38 ft. after 24 hours pumping 1,000 gpm
 Est. Yield 1,000 gpm: Well water was ft. after hours pumping gpm
 Bore Hole Diameter: 3.0 in. to ft., and in. to ft.
 WELL WATER TO BE USED AS:
 1 Domestic 3 Feedlot 6 Oil field water supply 9 Dewatering 11 Injection well
 2 Irrigation 4 Industrial 7 Lawn and garden only 10 Monitoring well 12 Other (Specify below)
 Was a chemical/bacteriological sample submitted to Department? Yes.....No X.....; If yes, mo/day/yr sample was submitted
 Water Well Disinfected? Yes X No

5 TYPE OF BLANK CASING USED:
 1 Steel 3 RMP (SR) 5 Wrought iron 8 Concrete tile CASING JOINTS: Glued X Clamped
 2 PVC 4 ABS 7 Fiberglass Threaded.
 Blank casing diameter: 1.6 in. to 3.5 ft., Dia in. to ft., Dia in. to ft.
 Casing height above land surface: 12 in., weight SCH 40 lbs./ft. Wall thickness or gauge No.
 TYPE OF SCREEN OR PERFORATION MATERIAL:
 1 Steel 3 Stainless steel 5 Fiberglass 7 PVC 8 RMP (SR) 10 Asbestos-cement
 2 Brass 4 Galvanized steel 6 Concrete tile 9 ABS 11 Other (specify)
 12 None used (open hole)
 SCREEN OR PERFORATION OPENINGS ARE:
 1 Continuous slot 3 Mill slot 5 Gauzed wrapped 8 Saw cut 11 None (open hole)
 2 Louvered shutter 4 Key punched 6 Wire wrapped 9 Drilled holes
 7 Torch cut 10 Other (specify)
 SCREEN-PERFORATED INTERVALS: From 35 ft. to 75 ft., From ft. to ft.
 GRAVEL PACK INTERVALS: From 75 ft. to 25 ft., From ft. to ft.

6 GROUT MATERIAL: 1 Neat cement 2 Cement grout 3 Bentonite 4 Other
 Grout Intervals: From 2 ft. to 18 ft., From ft. to ft., From ft. to ft.
 What is the nearest source of possible contamination:
 1 Septic tank 4 Lateral lines 7 Pit privy 10 Livestock pens 14 Abandoned water well
 2 Sewer lines 5 Cess pool 8 Sewage lagoon 11 Fuel storage 15 Oil well/Gas well
 3 Watertight sewer lines 6 Seepage pit 9 Feedyard 12 Fertilizer storage 16 Other (specify below)
 13 Insecticide storage
 Direction from well? North How many feet? 50

FROM	TO	LITHOLOGIC LOG	FROM	TO	PLUGGING INTERVALS
0	2	Sandy Top soil			
2	8	Coarse sand			
8	22	Coarse Blue sand & Gravel			
22	29	Blue Med. Gravel			
29	37	Blue, coarse Gravel & mixed Blue clay			
37	38	Fine sand			
38	44	Blue Med. Gravel			
44	47	Reworked formation			
47	50	Med. Gravel, Blue tint			
50	55	Sandy, Blue & Gray clay			
55	65	Layers of clay, Limestone & Gravel, mixed			
65	68	Gravel & limestone, mixed			
68	73	Gray clay			
73	75	Black clay			

7 CONTRACTOR'S OR LANDOWNER'S CERTIFICATION: This water well was (1) constructed, (2) reconstructed, or (3) plugged under my jurisdiction and was completed on (mo/day/year) 6/1/95 and this record is true to the best of my knowledge and belief. Kansas Water Well Contractor's License No. 480 This Water Well Record was completed on (mo/day/yr) 6/26/95 under the business name of Williams Drilling Inc. by (signature) Ron Williams