


1 LOCATION OF WATER WELL: Fraction NE 1/4 NW 1/4 NW 1/4 Section Number 17 Township Number T 3 S Range Number R 4 E/W
 County: REPUBLIC
 Distance and direction from nearest town or city street address of well if located within city?

2 WATER WELL OWNER: Mrs. Alvie Thompson
 RR#, St. Address, Box # : Scandia, Ks 66966
 City, State, ZIP Code :
 Board of Agriculture, Division of Water Resources
 Application Number:

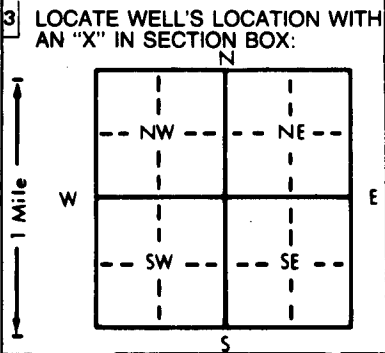

4 DEPTH OF COMPLETED WELL... 6.0 ft. ELEVATION:
 Depth(s) Groundwater Encountered 1. ft. 2. ft. 3. ft.
 WELL'S STATIC WATER LEVEL ... 8 ft. below land surface measured on mo/day/yr
 Pump test data: Well water was ... 5.9 ft. after ... 1.2 hours pumping ... 800 gpm
 Est. Yield .. 800 gpm: Well water was ... 5.9 ft. after ... 1.2 hours pumping .. 800 gpm
 Bore Hole Diameter... 3.0 in. to ... 6.0 in. to ... in. to ... in.
 WELL WATER TO BE USED AS: 5 Public water supply 8 Air conditioning 11 Injection well
 1 Domestic 3 Feedlot 6 Oil field water supply 9 Dewatering 12 Other (Specify below)
 2 Irrigation 4 Industrial 7 Lawn and garden only 10 Monitoring well
 Was a chemical/bacteriological sample submitted to Department? Yes.....No.....; If yes, mo/day/yr sample was submitted
 Water Well Disinfected? Yes No

5 TYPE OF BLANK CASING USED: 1 Steel 2 PVC 3 RMP (SR) 4 ABS 5 Wrought iron 6 Asbestos-Cement 7 Fiberglass 8 Concrete tile 9 Other (specify below) CASING JOINTS: Glued Clamped Welded Threaded
 Blank casing diameter ... 16 in. to ... 40 in. Dia ... in. to ... in. Dia ... in. to ... in. Dia ... in. to ... in. Dia
 Casing height above land surface ... in., weight ... lbs./ft. Wall thickness or gauge No.
 TYPE OF SCREEN OR PERFORATION MATERIAL: 1 Steel 2 Brass 3 Stainless steel 4 Galvanized steel 5 Fiberglass 6 Concrete tile 7 PVC 8 RMP (SR) 9 ABS 10 Asbestos-cement 11 Other (specify) 12 None used (open hole)
 SCREEN OR PERFORATION OPENINGS ARE: 1 Continuous slot 2 Louvered shutter 3 Mill slot 4 Key punched 5 Gauzed wrapped 6 Wire wrapped 7 Torch cut 8 Saw cut 9 Drilled holes 10 Other (specify) High Tech 11 None (open hole)
 SCREEN-PERFORATED INTERVALS: From ... 40 ft. to ... 60 ft. From ... ft. to ... ft. From ... ft. to ... ft. From ... ft. to ... ft.
 GRAVEL PACK INTERVALS: From ... 60 ft. to ... 30 ft. From ... ft. to ... ft. From ... ft. to ... ft. From ... ft. to ... ft.

6 GROUT MATERIAL: 1 Neat cement 2 Cement grout 3 Bentonite 4 Other
 Grout Intervals: From ... 30 ft. to ... 20 ft. From ... ft. to ... ft. From ... ft. to ... ft. From ... ft. to ... ft.
 What is the nearest source of possible contamination: 1 Septic tank 2 Sewer lines 3 Watertight sewer lines 4 Lateral lines 5 Cess pool 6 Seepage pit 7 Pit privy 8 Sewage lagoon 9 Feedyard 10 Livestock pens 11 Fuel storage 12 Fertilizer storage 13 Insecticide storage 14 Abandoned water well 15 Oil well/Gas well 16 Other (specify below)
 Direction from well? West How many feet? 25

| FROM | TO | LITHOLOGIC LOG | FROM | TO | PLUGGING INTERVALS |
|------|----|---|------|----|--------------------|
| 0 | 5 | Sandy soil | | | |
| 5 | 10 | Med. Gravel | | | |
| 10 | 15 | Coarse sand | | | |
| 15 | 20 | Blue, coarse sand | | | |
| 20 | 25 | Blue, coarse Gravel, Flat Limestone rocks | | | |
| 25 | 30 | Blue, coarse Gravel, Flat Rocks | | | |
| 30 | 35 | Coarse Gravel, Blue Rocks | | | |
| 35 | 41 | Coarse Gravel, Blue | | | |
| 41 | 45 | Coarse sand, Blue | | | |
| 45 | 48 | Coarse sand, Blue | | | |
| 48 | 55 | Coarse sand, mixed w/limestone | | | |
| 55 | 60 | Blue, Gray clay | | | |

7 CONTRACTOR'S OR LANDOWNER'S CERTIFICATION: This water well was (1) constructed, (2) reconstructed, or (3) plugged under my jurisdiction and was completed on (mo/day/year) 5/16/94 and this record is true to the best of my knowledge and belief. Kansas Water Well Contractor's License No. 480 This Water Well Record was completed on (mo/day/yr) by (signature) [Signature]

INSTRUCTIONS: Use typewriter or ball point pen. PLEASE PRESS FIRMLY and PRINT clearly. Please fill in blanks, underline or circle the correct answers. Send top three copies to Kansas Department of Health and Environment, Bureau of Water, Topeka, Kansas 66620-0001. Telephone: 913-296-5545. Send one to WATER WELL OWNER and retain one for your records.