

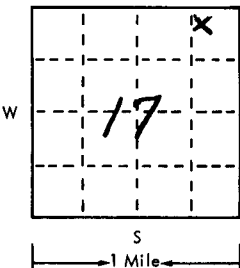
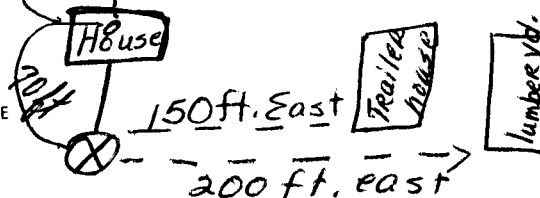
Revised copy

USE TYPEWRITER OR BALL
POINT PEN—PRESS FIRMLY,
PRINT CLEARLY.

WATER WELL RECORD
KSA 82a-1201-1215

3 4W 17 NW NE NE
T R EW sec 1/4 1/4 1/4 No.

Kansas State Dept. Of Health
(Water Well Contractors)
Forbes-Bldg. 740
Topeka, Kansas 66620

1 Location of well:	County Republic	Township name Scandia	Fraction NW 1/4 NE 1/4 NE 1/4	Section number 17	Town number 3	Range number 4 W
Distance and direction from nearest town or city: in Scandia			3 Owner of well: Cleo Bruster			
Street address of well location if in city: main street (2 houses southwest of city sewer)			Address: Scandia, KS 6669			
Locate with "X" in section below: N  W S 1 Mile			Sketch map: Lumber yard 		4 Well depth: 24 ft. Date of completion 9-22-75 Well diameter 5 in.	
2 Type and color of material			From To		5 <input type="checkbox"/> Cable tool <input checked="" type="checkbox"/> Rotary <input type="checkbox"/> Driven <input type="checkbox"/> Dug <input type="checkbox"/> Hollow rod <input type="checkbox"/> Jetted <input type="checkbox"/> Bored <input type="checkbox"/> Reverse rotary	
					6 Use: <input checked="" type="checkbox"/> Domestic <input type="checkbox"/> Public supply <input type="checkbox"/> Industry <input type="checkbox"/> Irrigation <input type="checkbox"/> Air conditioning <input type="checkbox"/> Commercial <input type="checkbox"/> Test well <input checked="" type="checkbox"/> garden & lawn	
					7 Casing: Material RMP Height: above below Threaded <input type="checkbox"/> Welded <input checked="" type="checkbox"/> Surface 18 in. Diam. 5 in. to 24 ft. depth! Drive shoe? <input type="checkbox"/> Yes <input type="checkbox"/> No 5 in. to 24 ft. depth!	
					8 Screen: Manufacturer Jones Type RMP Dia. 5 Slot gauge .025 Length 10 Set between 14 ft. and 24 ft. Fittings: 1 1/2 x 1/8 1/4 Gravel pack <input checked="" type="checkbox"/> Yes <input type="checkbox"/> No Size range of material	
top soil & sand			0 8		9 Static water level: 15 ft. below land surface Date 9-19-75	
small gravel & sand			8 14		10 Pumping level below land surfaces: ____ ft. after ____ hrs. pumping ____ g.p.m. none after ____ hrs. pumping ____ g.p.m. Estimated maximum yield ____ g.p.m.	
Brown clay			14 15		11 Water sample submitted: none <input type="checkbox"/> Yes <input type="checkbox"/> No Date ____	
gravel large 1/4 & 1/8 size			15 24		12 Well head completion: none <input type="checkbox"/> Pitless adapter <input type="checkbox"/> Inches above grade	
					13 Well grouted? <input checked="" type="checkbox"/> Yes <input type="checkbox"/> No <input type="checkbox"/> Neat cement <input checked="" type="checkbox"/> Bentonite <input type="checkbox"/> _____ Depth: From 0 ft. to 10 ft.	
city sewer in the city of Scandia no cesspool or septic tanks.					14 Nearest source of possible contamination: 770' from sewer line, city sewer Type ____ Well disinfected upon completion? <input checked="" type="checkbox"/> Yes <input type="checkbox"/> No	
					15 Pump: <input checked="" type="checkbox"/> Not installed Manufacturer's name ____ Model number ____ HP ____ Volts ____ Length of drop pipe ____ ft. capacity ____ g.m.p. Type: <input type="checkbox"/> Submersible <input type="checkbox"/> Turbine <input type="checkbox"/> Jet <input type="checkbox"/> Reciprocating <input type="checkbox"/> Centrifugal <input type="checkbox"/> Other	
16 Remarks: elevation 1450' Concrete slab to be completed by customer.			17 Water well contractor's certification: This well was drilled under my jurisdiction and this report is true to the best of my knowledge and belief. Tri-Valley Irr. 304 Business name License No. Address Box 26 Norway KS Signed Jerry Killen Date 9-22-75 Authorized representative			