


1 LOCATION OF WATER WELL: County: Republic Fraction NW 1/4 NE 1/4 NW 1/4 Section Number 18 Township Number T 3 S Range Number R 4 W

Distance and direction from nearest town or city street address of well if located within city?
2 West of Scandia

2 WATER WELL OWNER: Republican Valley Feeders
 RR#, St. Address, Box # : Scandia, Kansas 66966 Board of Agriculture, Division of Water Resources
 City, State, ZIP Code : Application Number: _____

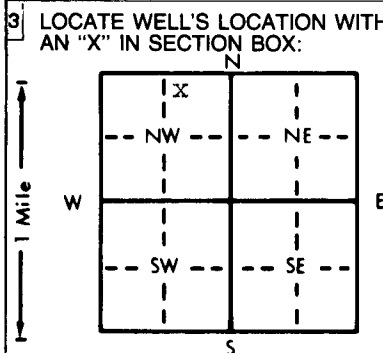

4 DEPTH OF COMPLETED WELL: 31 ft. ELEVATION: 1440'
 Depth(s) Groundwater Encountered 1 ft. 2. _____ ft. 3. _____ ft.
 WELL'S STATIC WATER LEVEL 6 ft. below land surface measured on mo/day/yr 11/2/1983
 Pump test data: Well water was NA ft. after _____ hours pumping _____ gpm
 Est. Yield 240 gpm: Well water was _____ ft. after _____ hours pumping _____ gpm
 Bore Hole Diameter 30 in. to 31 in. to _____ in. to _____ in.
 WELL WATER TO BE USED AS:
 5 Public water supply 8 Air conditioning 11 Injection well
 1 Domestic xxx3 Feedlot 6 Oil field water supply 9 Dewatering 12 Other (Specify below)
 2 Irrigation 4 Industrial 7 Lawn and garden only 10 Observation well
 Was a chemical/bacteriological sample submitted to Department? Yes _____ No xxx; If yes, mo/day/yr sample was submitted _____
 Water Well Disinfected? Yes xxx No _____

5 TYPE OF BLANK CASING USED:
 1 Steel 3 RMP (SR) xxx6 Asbestos-Cement 8 Concrete tile CASING JOINTS: Glued _____ Clamped xxx
 2 PVC 4 ABS 7 Fiberglass _____ Welded _____
 5 Wrought iron 9 Other (specify below) _____ Threaded _____
 Blank casing diameter 16 in. to 18 in. Dia _____ in. to _____ in. Dia _____ in. to _____ in. Dia _____
 Casing height above land surface 24 in., weight 30 lbs./ft. Wall thickness or gauge No. 3/4"
 TYPE OF SCREEN OR PERFORATION MATERIAL:
 1 Steel 3 Stainless steel 5 Fiberglass 7 PVC xxxAsbestos-cement
 2 Brass 4 Galvanized steel 6 Concrete tile 8 RMP (SR) 11 Other (specify) _____
 9 ABS 12 None used (open hole)
 SCREEN OR PERFORATION OPENINGS ARE:
 1 Continuous slot 3 Mill slot 5 Gauzed wrapped xxx8 Saw cut 11 None (open hole)
 2 Louvered shutter 4 Key punched 6 Wire wrapped 9 Drilled holes
 7 Torch cut 10 Other (specify) _____
 SCREEN-PERFORATED INTERVALS: From 18 ft. to 31 ft., From _____ ft. to _____ ft.
 From _____ ft. to _____ ft., From _____ ft. to _____ ft.
 GRAVEL PACK INTERVALS: From 10 ft. to 31 ft., From _____ ft. to _____ ft.
 From _____ ft. to _____ ft., From _____ ft. to _____ ft.

6 GROUT MATERIAL: 1 Neat cement xxx2 Cement grout 3 Bentonite 4 Other _____
 Grout Intervals: From 0 ft. to 10 ft., From _____ ft. to _____ ft., From _____ ft. to _____ ft.
 What is the nearest source of possible contamination:
 1 Septic tank 4 Lateral lines 7 Pit privy xxx10 Livestock pens 14 Abandoned water well
 2 Sewer lines 5 Cess pool 8 Sewage lagoon 11 Fuel storage 15 Oil well/Gas well
 3 Watertight sewer lines 6 Seepage pit 9 Feedyard 12 Fertilizer storage 16 Other (specify below)
 13 Insecticide storage _____
 Direction from well? South How many feet? 50

FROM	TO	LITHOLOGIC LOG	FROM	TO	LITHOLOGIC LOG
0	3	<u>0</u> topsoil			
3	11	<u>05</u> sand (sleeve set)			
11	18	<u>14</u> gravel (medium)			
18	27	<u>15</u> gravel (coarse)			
27	30	<u>17</u> blue shale			
30		stop			

7 CONTRACTOR'S OR LANDOWNER'S CERTIFICATION: This water well was 2 constructed, (2) reconstructed, or (3) plugged under my jurisdiction and was completed on (mo/day/year) November 1, 1983 and this record is true to the best of my knowledge and belief. Kansas Water Well Contractor's License No. 359 This Water Well Record was completed on (mo/day/yr) 11/2/1983 under the business name of Daryl Cox & Sons Inc. by (signature) Daryl Cox

INSTRUCTIONS: Use typewriter or ball point pen, PLEASE PRESS FIRMLY and PRINT clearly. Please fill in blanks, underline or circle the correct answers. Send top three copies to Kansas Department of Health and Environment, Division of Environment, Environmental Geology Section, Topeka, KS 66620. Send one to WATER WELL OWNER and retain one for your records.