


1 LOCATION OF WATER WELL: County: Republic Fraction: SE 1/4 NE 1/4 SW 1/4 Section Number: 18 Township Number: T 3 S Range Number: R 4 EW

Distance and direction from nearest town or city street address of well if located within city?  
1 mile West, 1 mile South, 1/2 West of Scandia, Kansas

2 WATER WELL OWNER: Republican Valley Feeders  
 RR#, St. Address, Box #: RR Board of Agriculture, Division of Water Resources  
 City, State, ZIP Code: Scandia, Kansas 66966 Application Number:

3 LOCATE WELL'S LOCATION WITH AN "X" IN SECTION BOX:

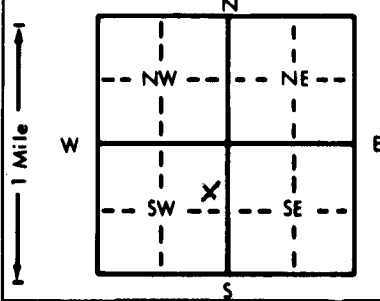

4 DEPTH OF COMPLETED WELL: 45 ft. ELEVATION: Unknown 1450'  
 Depth(s) Groundwater Encountered: 1, 17, 5" ft. 2. .... ft. 3. .... ft.  
 WELL'S STATIC WATER LEVEL: 17, 5" ft. below land surface measured on 3/27/87 mo/day/yr  
 Pump test data: Well water was 34 1/2 ft. after 9 hours pumping 155 gpm  
 Est. Yield 150 gpm: Well water was .... ft. after .... hours pumping .... gpm  
 Bore Hole Diameter: 12 in. to 45 ft., and .... in. to .... ft.  
 WELL WATER TO BE USED AS:  
 5 Public water supply 8 Air conditioning 11 Injection well  
 1 Domestic 3 Feedlot 6 Oil field water supply 9 Dewatering 12 Other (Specify below)  
 2 Irrigation 4 Industrial 7 Lawn and garden only 10 Observation well  
 Was a chemical/bacteriological sample submitted to Department? Yes.....No...X.....; If yes, mo/day/yr sample was submitted  
 Water Well Disinfected? Yes X No

5 TYPE OF BLANK CASING USED:  
 1 Steel 3 RMP (SR) 5 Wrought iron 8 Concrete tile CASING JOINTS: Glued Clamped  
2 PVC 4 ABS 6 Asbestos-Cement 9 Other (specify below) Welded  
 7 Fiberglass Threaded  
 Blank casing diameter: 8 in. to 28 ft., Dia. .... in. to .... ft., Dia. .... in. to .... ft.  
 Casing height above land surface: 24 in., weight 5.6 lbs./ft. Wall thickness or gauge No. 332

TYPE OF SCREEN OR PERFORATION MATERIAL:  
 1 Steel 3 Stainless steel 5 Fiberglass 7 PVC 10 Asbestos-cement  
 2 Brass 4 Galvanized steel 6 Concrete tile 9 ABS 11 Other (specify) ....  
 12 None used (open hole)

SCREEN OR PERFORATION OPENINGS ARE:  
 1 Continuous slot 3 Mill slot 5 Gauzed wrapped 8 Saw cut 11 None (open hole)  
 2 Louvered shutter 4 Key punched 6 Wire wrapped 9 Drilled holes  
 7 Torch cut 10 Other (specify) .....

SCREEN-PERFORATED INTERVALS: From 28 ft. to 45 ft., From .... ft. to .... ft.  
 From .... ft. to .... ft., From .... ft. to .... ft.  
 GRAVEL PACK INTERVALS: From 25 ft. to 45 ft., From .... ft. to .... ft.  
 From .... ft. to .... ft., From .... ft. to .... ft.

6 GROUT MATERIAL: 1 Neat cement 2 Cement grout 3 Bentonite 4 Other  
 Grout intervals: From 3 ft. to 25 ft., From .... ft. to .... ft., From .... ft. to .... ft.

What is the nearest source of possible contamination:  
 1 Septic tank 4 Lateral lines 7 Pit privy 10 Livestock pens 14 Abandoned water well  
 2 Sewer lines 5 Cess pool 8 Sewage lagoon 11 Fuel storage 15 Oil well/Gas well  
 3 Watertight sewer lines 6 Seepage pit 9 Feedyard 12 Fertilizer storage 16 Other (specify below)  
 13 Insecticide storage  
 Direction from well? North How many feet? 600

FROM	TO	LITHOLOGIC LOG	FROM	TO	LITHOLOGIC LOG
0	2	Topsoil			
2	16	Clay, Brown to Tan			
16	19	Sand, Med.			
19	21	Sand, Coarse			
21	36	Sand & Gravel			
36	61	Shale			

7 CONTRACTOR'S OR LANDOWNER'S CERTIFICATION: This water well was (1) constructed, (2) reconstructed, or (3) plugged under my jurisdiction and was completed on (mo/day/year) 4/25/87 and this record is true to the best of my knowledge and belief. Kansas Water Well Contractor's License No. 480 This Water Well Record was completed on (mo/day/yr) 4/20/88 under the business name of Williams Drilling Co., Inc. by (signature) Ron Williams

INSTRUCTIONS: Use typewriter or ball point pen. PLEASE PRESS FIRMLY and PRINT clearly. Please fill in blanks, underline or circle the correct answers. Send top three copies to Kansas Department of Health and Environment, Office of Oil Field and Environmental Geology, Regulation and Permitting Section, Topeka, Kansas 66620-7500, Telephone: 913-862-9360. Send one to WATER WELL OWNER and retain one for your records.