


1 LOCATION OF WATER WELL: County: Republic Fraction NW $\frac{1}{4}$ NN $\frac{1}{4}$ NW $\frac{1}{4}$ Section Number 23 Township Number T 3 S Range Number R 4 E/W

Distance and direction from nearest town or city street address of well if located within city?
From Bellville--- 6 Miles West, $2\frac{1}{2}$ mile South on Eastside of road

2 WATER WELL OWNER: Paul Boman
RR#, St. Address, Box # : Rt 2 Board of Agriculture, Division of Water Resources
City, State, ZIP Code : Scandia, NE 66966 Application Number:

3 LOCATE WELL'S LOCATION WITH AN "X" IN SECTION BOX:

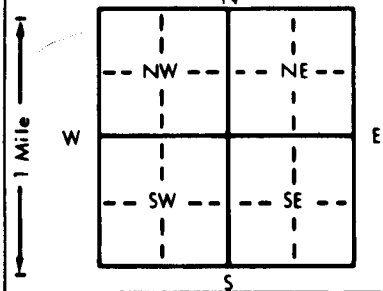

4 DEPTH OF COMPLETED WELL... 6.0 ft. ELEVATION:
Depth(s) Groundwater Encountered 1. ft. 2. ft. 3. ft.
WELL'S STATIC WATER LEVEL . . . 1.2 . . . ft. below land surface measured on mo/day/yr . . . 5 / 20 / 94 . . .
Pump test data: Well water was ft. after hours pumping gpm
Est. Yield gpm: Well water was ft. after hours pumping gpm
Bore Hole Diameter . . . 1.0 . . . in. to . . . 6.0 . . . ft., and in. to ft.
WELL WATER TO BE USED AS: 5 Public water supply 8 Air conditioning 11 Injection well
Domestic 3 Feedlot 6 Oil field water supply 9 Dewatering 12 Other (Specify below)
2 Irrigation 4 Industrial 7 Lawn and garden only 10 Monitoring well
Was a chemical/bacteriological sample submitted to Department? Yes. No.; If yes, mo/day/yr sample was submitted Water Well Disinfected? Yes No

5 TYPE OF BLANK CASING USED:
1 Steel 3 RMP (SR) 5 Wrought iron 8 Concrete tile CASING JOINTS: Glued Clamped
PVC 4 ABS 7 Fiberglass Welded
Blank casing diameter . . . 5 . . . in. to . . . 4.0 . . . ft., Dia in. to ft., Dia in. to ft.
Casing height above land surface in., weight lbs./ft. Wall thickness or gauge No.

TYPE OF SCREEN OR PERFORATION MATERIAL:
1 Steel 3 Stainless steel 5 Fiberglass 8 RMP (SR) 10 Asbestos-cement
2 Brass 4 Galvanized steel 6 Concrete tile 9 ABS 11 Other (specify)
SCREEN OR PERFORATION OPENINGS ARE:
1 Continuous slot 3 Mill slot 5 Gauzed wrapped 8 Saw cut 11 None (open hole)
2 Louvered shutter 4 Key punched 6 Wire wrapped 9 Drilled holes
7 Torch cut 10 Other (specify)

SCREEN-PERFORATED INTERVALS: From . . . 4.0 . . . ft. to . . . 6.0 . . . ft., From ft. to ft.
GRAVEL PACK INTERVALS: From . . . 6.0 . . . ft. to . . . 2.0 . . . ft., From ft. to ft.
From ft. to ft., From ft. to ft.

6 GROUT MATERIAL: 1 Neat cement 2 Cement grout 3 Bentonite 4 Other
Grout intervals: From . . . 0 . . . ft. to . . . 2.0 . . . ft., From ft. to ft.
What is the nearest source of possible contamination:
1 Septic tank 4 Lateral lines 7 Pit privy 10 Livestock pens 14 Abandoned water well
2 Sewer lines 5 Cess pool 8 Sewage lagoon 11 Fuel storage 15 Oil well/Gas well
3 Watertight sewer lines 6 Seepage pit 9 Feedyard 12 Fertilizer storage 16 Other (specify below)
13 Insecticide storage
Direction from well? SOUTH How many feet? 2000

FROM	TO	LITHOLOGIC LOG	FROM	TO	PLUGGING INTERVALS
0	10	Top soil & clay			
10	30	Brown, Sandy clay			
30	40	Reworked formation			
40	50	Blue clay			
50	60	Limestone			

7 CONTRACTOR'S OR LANDOWNER'S CERTIFICATION: This water well was (1) constructed, (2) reconstructed, or (3) plugged under my jurisdiction and was completed on (mo/day/year) 5/20/94 and this record is true to the best of my knowledge and belief. Kansas Water Well Contractor's License No. 480 This Water Well Record was completed on (mo/day/yr) under the business name of WILLIAMS DRILLING CO. INC. by (signature) Jon Williams