USE TYPEWRITER OR BALL POINT PEN-PRESS FIRMLY, PRINT CLEARLY.

WATER WELL RECORD
KSA 82a-1201-1215

Kansas Department of Health and Environment-Division of Environment
(Water well Contractors)
Topeka, Kansas 66620

1. Location of well:	County	Fraction	Section number	Township number	Range number
	Republic	SW 1/4 SE 1/4 SE 1/4	29	T 3 S	R 4 E (W)

2. Distance and direction from nearest town or city: 3 S - 1/2 W of Scandia

Street address of well location if in city:

3. Owner of well: Alsop Sand Co, Inc

R.R. or street:

City, state, zip code: Belleville Kansas

4. Locate with "X" in section below:

Sketch map:

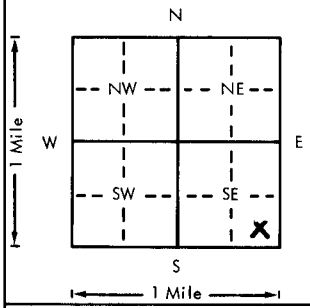

6. Bore hole dia. 32 in. Completion date 4-5-79
Well depth 47 ft.

7. __ Cable tool __ Rotary __ Driven __ Dug
__ Hollow rod __ Jetted __ Bored X Reverse rotary

8. Use: __ Domestic __ Public supply X Industry
__ Irrigation __ Air conditioning __ Stock
__ Lawn __ Oil field water __ Other

9. Casing: Material ~~Asbestos~~ Cement Above ~~or below~~ surface 12 in.
Threaded ___ Welded ___ RMP ___ PVC ___ Weight 34 lbs./ft.
Dia. 16 in. to 47 ft. depth Wall Thickness: inches or
Dia. ___ in. to ___ ft. depth ~~gage No.~~ 3/4

10. Screen: Manufacturer's name Hastings Casing Co.
Type Tresolite Dia. 16"
Slot/~~gauze~~ 1/8 Length 26 double
Set between 21 ft. and 47 ft.
___ ft. and ___ ft.
Gravel pack? YES Size range of material 1/8-1/4

11. Static water level: mo./day/yr.
12 ft. below land surface Date 3-6-79

12. Pumping level below land surfaces:
30 ft. after 1 hrs. pumping 1300 g.p.m.
___ ft. after ___ hrs. pumping ___ g.p.m.
Estimated maximum yield 2500 g.p.m.

13. Water sample submitted: mo./day/yr.
___ Yes X No Date

14. Well head completion:
___ Pitless adapter 12 Inches above grade

15. Well grouted? YES
With: ___ Neat cement ___ Bentonite X Concrete
Depth: From 0 ft. to 10 ft.

16. Nearest source of possible contamination: NONE
ft. ___ Direction ___ Type
Well disinfected upon completion? ___ Yes X No

17. Pump: Not installed
Manufacturer's name WLR 75
Model number 8N HP ~~10~~ Volts 480
Length of drop pipe ___ ft. capacity 1250 g.p.m.
Type:
___ Submersible X Turbine
___ Jet ___ Reciprocating
___ Centrifugal ___ Other

5. Type and color of material

Type and color of material	From	To
top soil + sand	0	14
gravel	14	46
clay + rocks	46	47

(Use a second sheet if needed)

18. Elevation: 1420

Topography:
___ Hill
___ Slope
___ Upland
X Valley

19. Remarks:

20. Water well contractor's certification:
This well was drilled under my jurisdiction and this report is true to the best of my knowledge and belief.
Business name Cox-Beswick License No. 361
Address Clifton, Kansas 6693
Signed Francis Cox Date 4-7-79
Authorized representative

T 3 R 4 E (W) Sec 29 1/4 SE SE 1/4

Forward the white, blue and pink copies to the Department of Health and Environment

Form WWC-5