


USE TYPEWRITER OR BALL POINT PEN-PRESS FIRMLY, PRINT CLEARLY.

WATER WELL RECORD
KSA 82a-1201-1215

Kansas Department of Health and Environment-Division of Environment
(Water well Contractors)
Topeka, Kansas 66620

1. Location of well: County **REPUBLIC** Fraction **SE 1/4 NE 1/4 NE 1/4** Section number **32** Township number **T 3 S R 4** Range number **4** E/D

2. Distance and direction from nearest town or city: **3 SOUTH** 3. Owner of well: **HARVEY MELBY**
Street address of well location if in city: **SCANDIA** R.R. or street: **ROUTE 1**
City, state, zip code: **SCANDIA, KANS 66966**

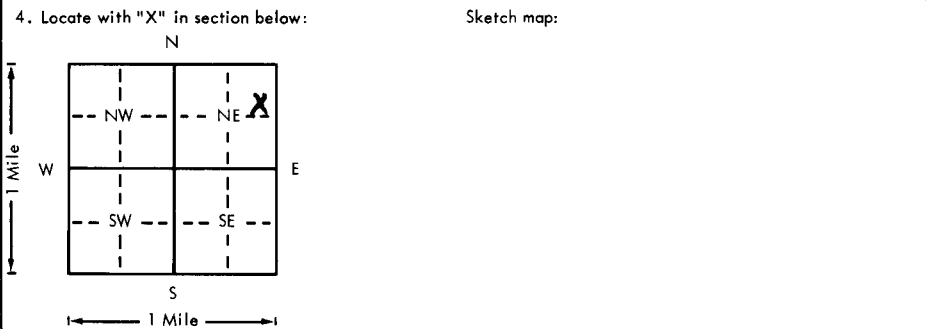

6. Bore hole dia. **8** in. Completion date **2/27/79**
Well depth **49** ft.
7. Cable tool Rotary Driven Dug
 Hollow rod Jetted Bored Reverse rotary
8. Use: Domestic Public supply Industry
 Irrigation Air conditioning Stock
 Lawn Oil field water Other
9. Casing: Material **PVC** Height: Above or below
Threaded Welded Surface **12** in.
RMP PVC Weight **3** lbs./ft.
Dia. **5** in. to **49** ft. depth Wall Thickness: inches or
Dia. in. to ft. depth Gauge No. **1258**

5. Type and color of material	From	To
TOPSOIL	0	3
BROWN CLAY	3	10
SAND	10	14
GRAVEL	14	58
Dk? SHALE	58	60
STOP	60	

10. Screen: Manufacturer's name **PUMPCO**
Type **PVC** Dia. **5"**
Slot gauge **1/16** Length **20'**
Set between **29** ft. and **49** ft.
ft. and ft.
Gravel pack? Yes Size range of material **5x4**
11. Static water level: **17** ft. below land surface Date mo./day/yr.
12. Pumping level below land surfaces:
 ft. after hrs. pumping g.p.m.
 ft. after hrs. pumping g.p.m.
Estimated maximum yield **35+** g.p.m.
13. Water sample submitted: Yes No Date mo./day/yr.
14. Well head completion: Pitless adapter **12** Inches above grade
15. Well grouted? Yes
With: Neat cement Bentonite Concrete
Depth: From **3** ft. to **13** ft.
16. Nearest source of possible contamination: **FEED LOT**
ft. **50** Direction **N** Type **LOT**
Well disinfected upon completion? Yes No
17. Pump: Not installed
Manufacturer's name HP Volts
Length of drop pipe ft. capacity g.p.m.
Type:
 Submersible Turbine
 Jet Reciprocating
 Centrifugal Other

18. Elevation: **370**
Topography: Hill Slope Upland Valley
19. Remarks:

20. Water well contractor's certification:
This well was drilled under my jurisdiction and this report is true to the best of my knowledge and belief.
DARYL COX + SONS INC 359
Business name License No.
Address **CLIFTON KANS 66937**
Signed **Daryl Cox** Date **2-28-79**
Authorized representative

T
W
R
4
E
D
32
SE 1/4 NE 1/4