


USE TYPEWRITER OR BALL POINT PEN-PRESS FIRMLY, PRINT CLEARLY.

WATER WELL RECORD
KSA 82a-1201-1215

Kansas Department of Health and Environment-Division of Environment (Water well Contractors) Topeka, Kansas 66620

1. Location of well: County Republic Fraction SW 1/4 NE 1/4 SW 1/4 Section number 33 Township number T 3 S R 4 E Range number 4

2. Distance and direction from nearest town or city: 4 S - 1/2 E 3. Owner of well: L J MELHUS
Street address of well location if in city: Scandia R.R. or street #2 City, state, zip code: Concordia, Ks 66901

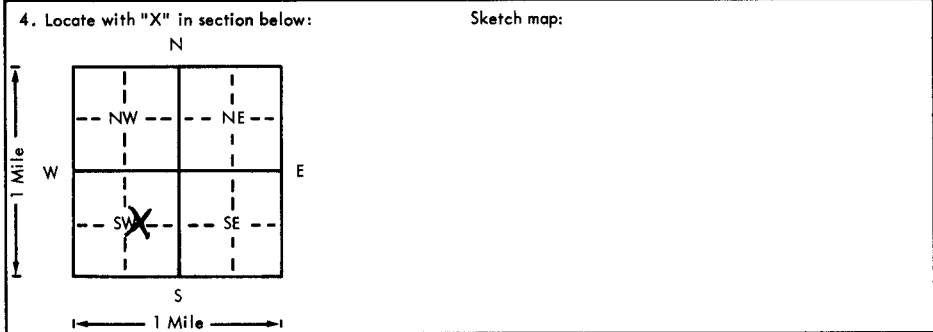

6. Bore hole dia. 7 1/2 in. Completion date 6-28-78
Well depth 67 ft.

7. Cable tool Rotary Driven Dug
 Hollow rod Jetted Bored Reverse rotary

8. Use: Domestic Public supply Industry
 Irrigation Air conditioning Stock
 Lawn Oil field water Other

9. Casing: Material AC Height: Above or below
Threaded Welded Surface 6 in.
RMP PVC Weight 34 lbs./ft.
Dia. 1 1/2 in. to 67 ft. depth Wall Thickness: inches or
Dia. in. to ft. depth gauge No. 3/4

5. Type and color of material	From	To
<u>clay</u>	<u>0</u>	<u>28</u>
<u>sand + gravel</u>	<u>28</u>	<u>30</u>
<u>gravel</u>	<u>30</u>	<u>40</u>
<u>sand + gravel</u>	<u>40</u>	<u>45</u>
<u>gravel</u>	<u>45</u>	<u>55</u>
<u>sand</u>	<u>55</u>	<u>56</u>
<u>gravel</u>	<u>56</u>	<u>68</u>
<u>clay + sand</u>	<u>68</u>	<u>75</u>

10. Screen: Manufacturer's name Johnson
Type triang Dia. 1 1/2
Slot/gauge 1/8 Length 26
Set between 41 ft. and 67 ft.
ft. and 67 ft.
Gravel pack? YES Size range of material 1/2-1/4

11. Static water level: 25 ft. below land surface Date 6-28-78 mo./day/yr.

12. Pumping level below land surfaces: NO TEST
 ft. after hrs. pumping g.p.m.
 ft. after hrs. pumping g.p.m.
Estimated maximum yield 1500 g.p.m.

13. Water sample submitted: mo./day/yr.
Yes No Date

14. Well head completion: 6 inches above grade
 Pitless adapter 6 inches above grade

15. Well grouted? YES
With: Neat cement Bentonite Concrete
Depth: From 0 ft. to 10 ft.

16. Nearest source of possible contamination: NONE
ft. Direction Type
Well disinfected upon completion? Yes No

17. Pump: Not installed
Manufacturer's name WLR
Model number 8M HP Volts
Length of drop pipe ft. capacity 900 g.p.m.
Type:
 Submersible Turbine
 Jet Reciprocating
 Centrifugal Other

18. Elevation: 1431
Topography:
 Hill
 Slope
 Upland
 Valley

19. Remarks: replacement well
no test pumping
6" casing above ground to leave
clearance for center pivot to go over

20. Water well contractor's certification:
This well was drilled under my jurisdiction and this report is true to the best of my knowledge and belief.
COX-BESWICK 361
Business name License No.
Address Clyton, Kansas
Signed Francis Cox Date 7-24
Authorized representative

T 3 S R 4 E
33 SW 1/4
Sec 33 SW 1/4