


WATER WELL RECORD Form WWC-5 KSA 82a-1212

1 LOCATION OF WATER WELL: County: Republic	Fraction NW 1/4 SE SE 1/4	Section Number 33	Township Number T 3 S	Range Number R 4W EW
--	-------------------------------------	-----------------------------	---------------------------------	--------------------------------

Distance and direction from nearest town or city street address of well if located within city?
3 Miles South 1 Mile East 1/4 Mile South of Scandia

2 WATER WELL OWNER: **Irvin Nondorf**
 RR#, St. Address, Box # : **Route 1**
 City, State, ZIP Code : **Scandia, Kansas 66966**
 Board of Agriculture, Division of Water Resources
 Application Number: _____

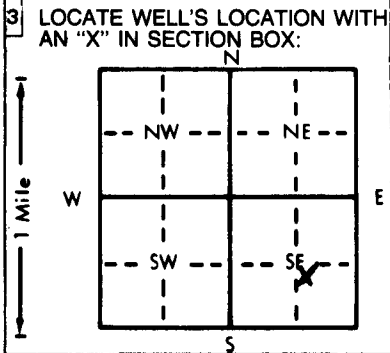

4 DEPTH OF COMPLETED WELL: **43'** ft. ELEVATION: **14.35'**
 Depth(s) Groundwater Encountered 1. **28'** ft. 2. _____ ft. 3. _____ ft.
 WELL'S STATIC WATER LEVEL **12'** ft. below land surface measured on mo/day/yr **6 - 19 - 81**
 Pump test data: Well water was _____ ft. after **1/2** hours pumping **500** gpm
 Est. Yield **500** gpm: Well water was _____ ft. after _____ hours pumping _____ gpm
 Bore Hole Diameter **3 3/4"** in. to **4 3/4"** ft., and _____ in. to _____ ft.
 WELL WATER TO BE USED AS:
 5 Public water supply 8 Air conditioning 11 Injection well
 1 Domestic 3 Feedlot 6 Oil field water supply 9 Dewatering 12 Other (Specify below)
X 2 Irrigation 4 Industrial 7 Lawn and garden only 10 Observation well
 Was a chemical/bacteriological sample submitted to Department? Yes _____ No _____; If yes, mo/day/yr sample was submitted _____
 Water Well Disinfected? Yes X No _____

5 TYPE OF BLANK CASING USED:
 1 Steel 3 RMP (SR) X 6 Asbestos-Cement 8 Concrete tile CASING JOINTS: Glued _____ Clamped X
 2 PVC 4 ABS 7 Fiberglass 9 Other (specify below) Welded _____
 Blank casing diameter **16"** in. to **17"** ft., Dia _____ in. to _____ ft., Dia _____ in. to _____ ft.
 Casing height above land surface **12"** in., weight **34** lbs./ft. Wall thickness or gauge No. **3/4"**
 TYPE OF SCREEN OR PERFORATION MATERIAL:
 1 Steel 3 Stainless steel 5 Fiberglass 7 PVC X 10 Asbestos-cement
 2 Brass 4 Galvanized steel 6 Concrete tile 8 RMP (SR) 11 Other (specify) _____
 9 ABS 12 None used (open hole)
 SCREEN OR PERFORATION OPENINGS ARE:
 5 Gauzed wrapped X 8 Saw cut 11 None (open hole)
 1 Continuous slot 3 Mill slot 6 Wire wrapped 9 Drilled holes
 2 Louvered shutter 4 Key punched 7 Torch cut 10 Other (specify) _____
 SCREEN-PERFORATED INTERVALS: From **17'** ft. to **43'** ft., From _____ ft. to _____ ft.
 From _____ ft. to _____ ft., From _____ ft. to _____ ft.
 GRAVEL PACK INTERVALS: From **10'** ft. to **43'** ft., From _____ ft. to _____ ft.
 From _____ ft. to _____ ft., From _____ ft. to _____ ft.

6 GROUT MATERIAL: 1 Neat cement X 2 Cement grout 3 Bentonite 4 Other _____
 Grout Intervals: From **0** ft. to **10** ft., From _____ ft. to _____ ft., From _____ ft. to _____ ft.
 What is the nearest source of possible contamination:
 1 Septic tank 4 Lateral lines 7 Pit privy 10 Livestock pens 14 Abandoned water well
 2 Sewer lines 5 Cess pool X 8 Sewage lagoon 11 Fuel storage 15 Oil well/Gas well
 3 Watertight sewer lines 6 Seepage pit 9 Feedyard 12 Fertilizer storage 16 Other (specify below)
 13 Insecticide storage
 Direction from well? **EAST** How many feet? **300'**

FROM	TO	LITHOLOGIC LOG	FROM	TO	LITHOLOGIC LOG
0	11	Top Soil & Clay			
11	28	Sand			
28	33	Gravel (good)			
33	38	Clay & Gravel			
38	43	Gravel (good)			
43		Shale			

7 CONTRACTOR'S OR LANDOWNER'S CERTIFICATION: This water well was (1) constructed, (2) reconstructed, or (3) plugged under my jurisdiction and was completed on (mo/day/year) **June 19, 1981** and this record is true to the best of my knowledge and belief. Kansas Water Well Contractor's License No. **361** This Water Well Record was completed on (mo/day/yr) **12 - 3 - 81**
 under the business name of **Cox-Beswick Irrigation Service, Inc.** by (signature) *Francis Cox*

INSTRUCTIONS: Use typewriter or ball point pen, PLEASE PRESS FIRMLY and PRINT clearly. Please fill in blanks, underline or circle the correct answers. Send top three copies to Kansas Department of Health and Environment, Division of Environment, Environmental Geology Section, Topeka, KS 66620. Send one to WATER WELL OWNER and retain one for your records.