


1 LOCATION OF WATER WELL: County: Republic Fraction SW 1/4 SW 1/4 NE 1/4 Section Number 33 Township Number T 3 S Range Number R 4 EW

Distance and direction from nearest town or city street address of well if located within city?

2 WATER WELL OWNER: DON LARSON RR#, St. Address, Box #: SCANDIA, KS 66966 Board of Agriculture, Division of Water Resources City, State, ZIP Code: Application Number:

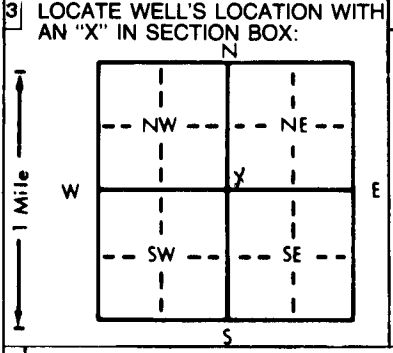

4 DEPTH OF COMPLETED WELL: 60 ft. ELEVATION: WELL'S STATIC WATER LEVEL: .22 ft. below land surface measured on mo/day/yr Pump test data: Well water was 33 ft. after 2 hours pumping 1000 gpm Est. Yield 1000 gpm: Well water was 33 ft. after 2 hours pumping 1000 gpm Bore Hole Diameter: 30 in. to 60 ft., and in. to ft. WELL WATER TO BE USED AS: 5 Public water supply 8 Air conditioning 11 Injection well 1 Domestic 3 Feedlot 6 Oil field water supply 9 Dewatering 12 Other (Specify below) 2 Irrigation 4 Industrial 7 Lawn and garden only 10 Monitoring well Was a chemical/bacteriological sample submitted to Department? Yes No; If yes, mo/day/yr sample was submitted Water Well Disinfected? Yes No

5 TYPE OF BLANK CASING USED: 1 Steel 3 RMP (SR) 6 Asbestos-Cement 9 Other (specify below) CASING JOINTS: Glued X Clamped Welded Threaded 2 PVC 4 ABS 7 Fiberglass Blank casing diameter: 16 in. to 40 ft., Dia. in. to ft., Dia. in. to ft. Casing height above land surface: in., weight lbs./ft. Wall thickness or gauge No. TYPE OF SCREEN OR PERFORATION MATERIAL: 1 Steel 3 Stainless steel 5 Fiberglass 8 RMP (SR) 10 Asbestos-cement 2 Brass 4 Galvanized steel 6 Concrete tile 9 ABS 11 Other (specify) H-1-CAP 12 None used (open hole) SCREEN OR PERFORATION OPENINGS ARE: 1 Continuous slot 3 Mill slot 6 Wire wrapped 9 Drilled holes 11 None (open hole) 2 Louvered shutter 4 Key punched 7 Torch cut 10 Other (specify) SCREEN-PERFORATED INTERVALS: From 40 ft. to 60 ft., From ft. to ft., From ft. to ft., From ft. to ft. GRAVEL PACK INTERVALS: From 50 ft. to 60 ft., From ft. to ft., From ft. to ft., From ft. to ft.

6 GROUT MATERIAL: 1 Neat cement 2 Cement grout 3 Bentonite 4 Other Grout Intervals: From 0 ft. to 20 ft., From ft. to ft., From ft. to ft., From ft. to ft. What is the nearest source of possible contamination: 1 Septic tank 4 Lateral lines 7 Pit privy 10 Livestock pens 14 Abandoned water well 2 Sewer lines 5 Cess pool 8 Sewage lagoon 11 Fuel storage 15 Oil well/Gas well 3 Watertight sewer lines 6 Seepage pit 9 Feedyard 12 Fertilizer storage 16 Other (specify below) 13 Insecticide storage n.o.n.e.

Direction from well? How many feet?

FROM	TO	LITHOLOGIC LOG	FROM	TO	PLUGGING INTERVALS
0	18	Top soil & clay			
18	28	Silty sand			
28	32	Silty sand			
32	38	Gravel, Coarse to Med.			
38	48	Gravel, Coarse			
48	54	Gravel, Coarse			
54	58	Clay			

7 CONTRACTOR'S OR LANDOWNER'S CERTIFICATION: This water well was (1) constructed, (2) reconstructed, or (3) plugged under my jurisdiction and was completed on (mo/day/year) 5/27/93 and this record is true to the best of my knowledge and belief. Kansas Water Well Contractor's License No. 480 This Water Well Record was completed on (mo/day/yr) 6/21/93 under the business name of WILLIAMS DRILLING CO., INC. by (signature) Dan Williams

INSTRUCTIONS: Use typewriter or ball point pen. PLEASE PRESS FIRMLY and PRINT clearly. Please fill in blanks, underline or circle the correct answers. Send top three copies to Kansas Department of Health and Environment, Bureau of Water, Topeka, Kansas 66620-0001. Telephone: 913-296-5545. Send one to WATER WELL OWNER and retain one for your records.