


1 LOCATION OF WATER WELL: Fraction SW 1/4 NW 1/4 NE 1/4 Section Number 32 Township Number T 3 S Range Number R 4 E/W
 County: Republic
 Distance and direction from nearest town or city street address of well if located within city?

2 WATER WELL OWNER: Harvey Melby
 RR#, St. Address, Box #: Box 63, RR 2 Board of Agriculture, Division of Water Resources
 City, State, ZIP Code: Scandia, KS 66966 Application Number:

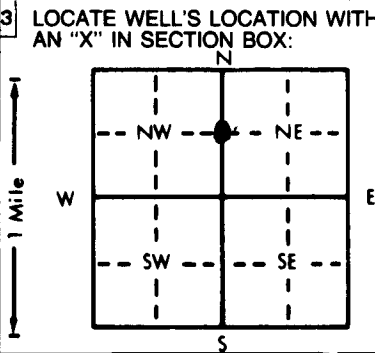

4 DEPTH OF COMPLETED WELL: 6.0 ft. ELEVATION:
 Depth(s) Groundwater Encountered 1. 8. ft. 2. ft. 3. ft.
 WELL'S STATIC WATER LEVEL: 8. ft. below land surface measured on mo/day/yr
 Pump test data: Well water was 2.0 ft. after 2.4 hours pumping gpm
 Est. Yield 1,000 gpm: Well water was 2.0 ft. after hours pumping gpm
 Bore Hole Diameter 30 in. to 60 ft., and in. to ft.
 WELL WATER TO BE USED AS:
 1 Domestic 2 Irrigation 3 Feedlot 4 Industrial 5 Public water supply 6 Oil field water supply 7 Lawn and garden only 8 Air conditioning 9 Dewatering 10 Monitoring well 11 Injection well 12 Other (Specify below)
 Was a chemical/bacteriological sample submitted to Department? Yes No X; If yes, mo/day/yr sample was submitted Water Well Disinfected? Yes No

5 TYPE OF BLANK CASING USED:
 1 Steel 2 PVC 3 RMP (SR) 4 ABS 5 Wrought iron 6 Asbestos-Cement 7 Fiberglass 8 Concrete tile 9 Other (specify below) CASING JOINTS: Glued Clamped Welded Threaded
 Blank casing diameter 16 in. to 30 ft., Dia in. to ft., Dia in. to ft.
 Casing height above land surface in., weight lbs./ft. Wall thickness or gauge No.
 TYPE OF SCREEN OR PERFORATION MATERIAL:
 1 Steel 2 Brass 3 Stainless steel 4 Galvanized steel 5 Fiberglass 6 Concrete tile 7 PVC 8 RMP (SR) 9 ABS 10 Asbestos-cement 11 Other (specify) 12 None used (open hole)
 SCREEN OR PERFORATION OPENINGS ARE:
 1 Continuous slot 2 Louvered shutter 3 Mill slot 4 Key punched 5 Gauzed wrapped 6 Wire wrapped 7 Torch cut 8 Saw cut 9 Drilled holes 10 Other (specify) 11 None (open hole)
 SCREEN-PERFORATED INTERVALS: From 30 ft. to 50 ft., From 50 ft. to 60 ft.
 GRAVEL PACK INTERVALS: From 60 ft. to 20 ft.

6 GROUT MATERIAL: Neat cement 2 Cement grout 3 Bentonite 4 Other
 Grout Intervals: From 20 ft. to 0 ft., From ft. to ft., From ft. to ft.
 What is the nearest source of possible contamination:
 1 Septic tank 2 Sewer lines 3 Watertight sewer lines 4 Lateral lines 5 Cess pool 6 Seepage pit 7 Pit privy 8 Sewage lagoon 9 Feedyard 10 Livestock pens 11 Fuel storage 12 Fertilizer storage 13 Insecticide storage 14 Abandoned water well 15 Oil well/Gas well 16 Other (specify below)
 Direction from well? How many feet?

FROM	TO	LITHOLOGIC LOG	FROM	TO	PLUGGING INTERVALS
0	5	Med. sand			
5	10	Fine sand			
10	12	Med. Gravel			
12	13	Coarse sand			
13	15	Blue Gravel, coarse			
15	29	River bed rocks & Blue Gravel			
29	35	Blue Gravel -- coarse-- ROCKS			
35	39	Blue Gravel -- medium -- ROCKS			
39	51	Blue Gravel -- coarse -- ROCKS			
51	53	Coarse sand, Blue -- ROCKS			
53	58	Blue Gravel, coarse -- ROCKS			
58	62	Coarse sand & Glue clay			
62	65	Limestone & Med. sand			

7 CONTRACTOR'S OR LANDOWNER'S CERTIFICATION: This water well was (1) constructed, (2) reconstructed, or (3) plugged under my jurisdiction and was completed on (mo/day/year) 7/15/94 and this record is true to the best of my knowledge and belief. Kansas Water Well Contractor's License No. 480 This Water Well Record was completed on (mo/day/yr) 7/28/94 under the business name of WILLIAMS DRILLING CO. INC. by (signature) Ron Williams

INSTRUCTIONS: Use typewriter or ball point pen. PLEASE PRESS FIRMLY and PRINT clearly. Please fill in blanks, underline or circle the correct answers. Send top three copies to Kansas Department of Health and Environment, Bureau of Water, Topeka, Kansas 66620-0001. Telephone: 913-296-5545. Send one to WATER WELL OWNER and retain one for your records.