


1 LOCATION OF WATER WELL:	Fraction	Section Number	Township Number	Range Number
County: REPUBLIC	SW 1/4 NE 1/4 NE 1/4	32	T 3 S	R 4 E/W

Distance and direction from nearest town or city street address of well if located within city?

2 WATER WELL OWNER: Harvey Melby
 RR#, St. Address, Box #: RR 2, Box 63
 City, State, ZIP Code: Scandia, KS 66966

Board of Agriculture, Division of Water Resources
 Application Number:

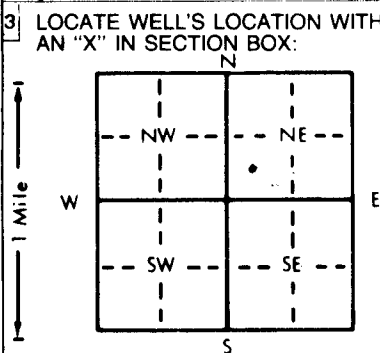

4 DEPTH OF COMPLETED WELL: 60 ft. ELEVATION:

Depth(s) Groundwater Encountered 1. 12 ft. 2. . ft. 3. . ft.

WELL'S STATIC WATER LEVEL: 12 ft. below land surface measured on mo/day/yr

Pump test data: Well water was 29 ft. after 1 hours pumping 1200 gpm
 Est. Yield 1200 gpm: Well water was . ft. after . hours pumping . gpm

Bore Hole Diameter: 30 in. to 60 ft., and . in. to . ft.

WELL WATER TO BE USED AS:

5 Public water supply	8 Air conditioning	11 Injection well
1 Domestic	3 Feedlot	6 Oil field water supply
2 Irrigation	4 Industrial	9 Dewatering
	7 Lawn and garden only	12 Other (Specify below)

Was a chemical/bacteriological sample submitted to Department? Yes No ; If yes, mo/day/yr sample was submitted

Water Well Disinfected? Yes No

5 TYPE OF BLANK CASING USED:

1 Steel	3 RMP (SR)	6 Asbestos-Cement	9 Other (specify below)
2 PVC	4 ABS	7 Fiberglass	

CASING JOINTS: Glued Clamped
 Welded
 Threaded

Blank casing diameter: 14 in. to 30 ft., Dia in. to ft., Dia in. to ft.

Casing height above land surface: 18 in., weight lbs./ft. Wall thickness or gauge No.

TYPE OF SCREEN OR PERFORATION MATERIAL:

1 Steel	3 Stainless steel	5 Fiberglass	8 RMP (SR)	10 Asbestos-cement
2 Brass	4 Galvanized steel	6 Concrete tile	9 ABS	11 Other (specify) Certa-Lok

SCREEN OR PERFORATION OPENINGS ARE:

1 Continuous slot	3 Mill slot	5 Gauzed wrapped	8 Saw cut	11 None (open hole)
2 Louvered shutter	4 Key punched	6 Wire wrapped	9 Drilled holes	
		7 Torch cut	10 Other (specify) Certa-Lok	

SCREEN-PERFORATED INTERVALS: From 30 ft. to 60 ft., From ft. to ft.
 From ft. to ft., From ft. to ft.

GRAVEL PACK INTERVALS: From 15 ft. to 60 ft., From ft. to ft.
 From ft. to ft., From ft. to ft.

6 GROUT MATERIAL: 1 Neat cement 2 Cement grout 3 Bentonite 4 Other

Grout Intervals: From 0 ft. to 15 ft., From ft. to ft., From ft. to ft.

What is the nearest source of possible contamination:

1 Septic tank	4 Lateral lines	7 Pit privy	10 Livestock pens	14 Abandoned water well
2 Sewer lines	5 Cess pool	8 Sewage lagoon	11 Fuel storage	15 Oil well/Gas well
3 Watertight sewer lines	6 Seepage pit	9 Feedyard	12 Fertilizer storage	16 Other (specify below)
			13 Insecticide storage	

Direction from well? ~~NORTH~~ SOUTH How many feet? 30

FROM	TO	LITHOLOGIC LOG	FROM	TO	PLUGGING INTERVALS
0	5	Med. Sand			
5	10	Fine sand			
10	12	Med. Gravel			
12	13	Coarse Sand			
13	15	Blue Gravel, Coarse			
15	29	River Bed, Rocks & Blue Gravel, coarse			
29	35	Blue Gravel, COARSE, ROCKS			
35	39	Blue Gravel, Med., ROCKS			
39	45	Blue Gravel, Coarse, ROCKS			
45	51	Blue Gravel, Coarse, ROCKS			
51	53	Coarse Sand, Blue, ROCKS			
53	58	Blue Gravel, Coarse, ROCKS			
58	62	Coarse sand & Blue clay			
62	65	Limestone & Med. sand			

7 CONTRACTOR'S OR LANDOWNER'S CERTIFICATION: This water well was (1) constructed, (2) reconstructed, or (3) plugged under my jurisdiction and was completed on (mo/day/year) 11/17/94 and this record is true to the best of my knowledge and belief. Kansas Water Well Contractor's License No. 480 This Water Well Record was completed on (mo/day/yr) 12/8/94

under the business name of WILLIAMS DRILLING CO. INC. by (signature) Ron Williams

INSTRUCTIONS: Use typewriter or ball point pen. PLEASE PRESS FIRMLY and PRINT clearly. Please fill in blanks, underline or circle the correct answers. Send top three copies to Kansas Department of Health and Environment, Bureau of Water, Topeka, Kansas 66620-0001. Telephone: 913-296-5545. Send one to WATER WELL OWNER and retain one for your records.