


1 LOCATION OF WATER WELL: County: **REPUBLIC** Fraction: **SW 1/4 NE 1/4 NE 1/4** Section Number: **20** Township Number: **T 3 S** Range Number: **R 4 E/W**

Distance and direction from nearest town or city street address of well if located within city?

2 WATER WELL OWNER: **Richard Boone**
 RR#, St. Address, Box # : **Santa Rosa, CA** Board of Agriculture, Division of Water Resources
 City, State, ZIP Code : Application Number:

3 LOCATE WELL'S LOCATION WITH AN "X" IN SECTION BOX:

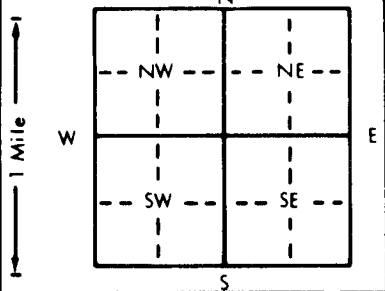

4 DEPTH OF COMPLETED WELL: **48** ft. ELEVATION:
 WELL'S STATIC WATER LEVEL: **11** ft. below land surface measured on mo/day/yr
 Bore Hole Diameter: **30** in. to **30** in. to **30** in.
 WELL WATER TO BE USED AS:
 1 Domestic 3 Feedlot 6 Oil field water supply 9 Dewatering 11 Injection well
 2 Irrigation 4 Industrial 7 Lawn and garden only 10 Monitoring well 12 Other (Specify below)
 Was a chemical/bacteriological sample submitted to Department? Yes No ; If yes, mo/day/yr sample was submitted
 Water Well Disinfected? Yes No

5 TYPE OF BLANK CASING USED:
 1 Steel 3 RMP (SR) 6 Asbestos-Cement 9 Other (specify below)
 2 PVC 4 ABS 7 Fiberglass CASING JOINTS: Glued Clamped
 Welded Threaded

TYPE OF SCREEN OR PERFORATION MATERIAL:
 1 Steel 3 Stainless steel 5 Fiberglass 8 RMP (SR) 10 Asbestos-cement
 2 Brass 4 Galvanized steel 6 Concrete tile 9 ABS 11 Other (specify)
 10 PVC 12 None used (open hole)

SCREEN OR PERFORATION OPENINGS ARE:
 1 Continuous slot 3 Mill slot 5 Gauzed wrapped 8 Saw cut 11 None (open hole)
 2 Louvered shutter 4 Key punched 6 Wire wrapped 9 Drilled holes
 7 Torch cut 10 Other (specify) **High-Tech 10'**

SCREEN-PERFORATED INTERVALS: From **1.7** ft. to **4.7** ft., From **4.7** ft. to **2.7** ft., From **2.7** ft. to **1.0** ft.
 GRAVEL PACK INTERVALS: From **4.7** ft. to **2.7** ft., From **2.7** ft. to **1.0** ft.

6 GROUT MATERIAL: 1 Neat cement 2 Cement grout 3 Bentonite 4 Other
 Grout Intervals: From **1.0** ft. to **0** ft., From **0** ft. to **0** ft., From **0** ft. to **0** ft.

What is the nearest source of possible contamination:
 1 Septic tank 4 Lateral lines 7 Pit privy 10 Livestock pens 14 Abandoned water well
 2 Sewer lines 5 Cess pool 8 Sewage lagoon 11 Fuel storage 15 Oil well/Gas well
 3 Watertight sewer lines 6 Seepage pit 9 Feedyard 12 Fertilizer storage 16 Other (specify below)
 13 Insecticide storage **NONE**

Direction from well? _____ How many feet? _____

FROM	TO	LITHOLOGIC LOG	FROM	TO	PLUGGING INTERVALS
0	2	Top soil			
2	7	Fine sand			
7	15	Green Gravel			
15	25	Green Gravel & Rocks			
25	35	Green Gravel & Rocks			
35	42	Green Gravel			
42	45	Blue & Brown clay			

7 CONTRACTOR'S OR LANDOWNER'S CERTIFICATION: This water well was (1) constructed, (2) reconstructed, or (3) plugged under my jurisdiction and was completed on (mo/day/year) **11/17/94** and this record is true to the best of my knowledge and belief. Kansas Water Well Contractor's License No. **480**. This Water Well Record was completed on (mo/day/yr) **12/12/94** under the business name of **Williams Drilling Co. INC.** by (signature) **Don Williams**