


1	LOCATION OF WATER WELL:	Fraction	Section Number	Township Number	Range Number
	County: <b>Cheyenne</b>	<b>NW 1/4 SW 1/4 NW 1/4</b>	<b>27</b>	<b>3S</b>	<b>40W</b>

Distance and direction from nearest town or city street address of well if located within city?

2 WATER WELL OWNER: **St Francis KDOT**  
 RR#, St. Address, Box # **RT 1, Box 297**  
 City, State, ZIP Code : **St. Francis, KS 67756**

Board of Agriculture, Division of Water Resources  
Application Number:

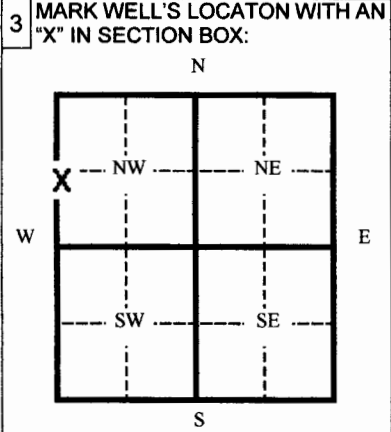

4 DEPTH OF WELL ..... **18** ..... ft.  
 WELL'S STATIC WATER LEVEL **12.6** ..... ft.

WELL WAS USED AS:

1 Domestic	5 Public Water Supply	9 Dewatering
2 Irrigation	6 Oil Field Water Supply	<input checked="" type="radio"/> 10 Monitoring Well
3 Feedlot	7 Lawn and Garden (domestic)	11 Injection Well
4 Industrial	8 Air Conditioning	12 Other .....

Was a chemical/bacteriological sample submitted to Department? Yes ..... No  **X**  
 If yes, mo/day/yr sample was submitted .....

Water Well Disinfected: Yes ..... No  **X**

5 TYPE OF BLANK CASING USED:

1 Steel	3 RMP (SR)	5 Wrought	7 Fiberglass	9 Other (specify below)
<input checked="" type="radio"/> 2 PVC	4 ABC	6 Asbestos-Cement	8 Concrete Tile	

Blank casing diameter ..... **2** ..... in. Was casing pulled? Yes ..... No  **X** If yes, how much **Overdrilled to 18 ft**

Casing height above or below land surface ..... **0** ..... in.

6 GROUT PLUG MATERIAL: 1 Neat cement 2 Cement grout  3 Bentonite 4 Other .....

Grout Plug Intervals From **1** ft. to **18** ft. From ..... ft. to ..... ft. From ..... ft. to ..... ft.

What is the nearest source of possible contamination:

1 Septic tank	6 Seepage pit	11 Fuel storage	16 Other (specify below)
2 Sewer lines	7 Pit privy	12 Fertilizer storage	<b>None</b>
3 Watertight sewer lines	8 Sewage lagoon	13 Insecticide storage	
4 Lateral lines	9 Feedyard	14 Abandoned water well	
5 Cess Pool	10 Livestock pens	15 Oil well/ Gas well	

Direction from well? ..... How many feet? .....

FROM	TO	CODE	PLUGGING MATERIALS
<b>18</b>	<b>3</b>		<b>Bentonite</b>
<b>3</b>	<b>0</b>		<b>Asphalt</b>

7 CONTRACTOR'S OR LANDOWNER'S CERTIFICATION: This water well was plugged under my jurisdiction and was completed on (mo/day/yr) ..... **2/28/06** ..... and this record is true to the best of my knowledge and belief. Kansas Water Well Contractor's License No. **554** This Water Well Record was completed on (mo/day/yr) ..... under the business name of **Woofter Pump & Well, Inc** by (signature) *Jay G Woofter*

INSTRUCTIONS: Please fill in blanks and circle the correct answers. Send three copies to Kansas Department of Health and Environment, Bureau of Water, 1000 S W Jackson St., Ste. 420, Topeka, Kansas 66620-0001. Telephone: 785-296-3565. Send one to Water Well Owner and retain one for your records.