

WATER WELL PLUGGING RECORD Form WWC-5P KSA 82a-1212 ID NO. MW 16


1 LOCATION OF WATER WELL: County: Cheyenne	Fraction ¼ sw ¼ ne ¼ nw ¼	Section Number 27	Township Number T 3 S	Range Number 40 <input type="checkbox"/> E <input checked="" type="checkbox"/> W
--	------------------------------	----------------------	--------------------------	---

Street/Rural Address of Well Location; if unknown, distance & direction from nearest town or intersection: If at owner's address, check here Highway 36 & Denison St St Francis, KS

Global Positioning Systems (GPS) information:
 Latitude: 39.76784 (in decimal degrees)
 Longitude: -101.79945 (in decimal degrees)
 Elevation: 3369.4
 Horizontal Datum: WGS84, NAD83, NAD27
 Collection Method:

2 WATER WELL OWNER: El Paso Remediation Co.
 RR#, St. Address, Box #: 1001 Louisiana St, Room 757C
 City, State ZIP Code: Houston, TX 77002

GPS unit (Make/Model):
 Digital Map/Photo, Topographic Map, Land Survey
 Est. Accuracy: < 3 m, 3-5 m, 5-15 m, > 15 m

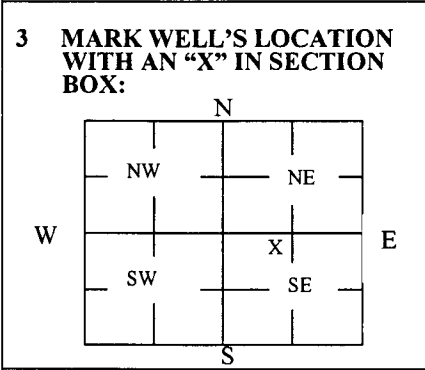

4 DEPTH OF WELL 49.80 ft.
 WELL'S STATIC WATER LEVEL 3324.26 ft
 WELL WAS USED AS:
 Domestic Public Water Supply Dewatering
 Irrigation Oil Field Water Supply Monitoring
 Feedlot Domestic (Lawn & Garden) Injection Well
 Industrial Air Conditioning Other MW-16

Was a chemical/bacteriological sample submitted to Department? Yes No

5 TYPE OF BLANK CASING USED:

Steel RMP (SR) Wrought Fiberglass Other (Specify below)
 PVC ABS Asbestos-Cement Concrete Tile

Blank casing diameter 2 in. Was casing pulled? Yes No If yes, how much _____
 Casing height above or below land surface -36 in.

6 GROUT PLUG MATERIAL: Neat cement Cement grout Bentonite Other _____

Grout Plug Intervals: From 0.5 ft. to 49.80 ft., From _____ ft. to _____ ft., From _____ ft. to _____ ft.

What is the nearest source of possible contamination:
 Septic tank Seepage pit Fuel storage Other (specify below)
 Sewer lines Pit privy Fertilizer storage Fuel pump station
 Watertight sewer lines Sewage lagoon Insecticide storage
 Lateral lines Feedyard Abandoned water well Direction from well? 155 feet
 Cess pool Livestock pens Oil well/Gas well How many feet? southeast

FROM	TO	PLUGGING MATERIALS	FROM	TO	PLUGGING MATERIALS
0	1.5	Native Soil			
1.5	49.80	Hi-solids/bentonite chips			

7 CONTRACTOR'S OR LANDOWNER'S CERTIFICATION: This water well was plugged under my jurisdiction and was completed on (mo/day/year) 04/18/2022 and this record is true to the best of my knowledge and belief. Kansas Water Well Contractor's License No. 929. This Water Well Record was completed on (mo/day/year) 05/13/2022 under the business name of Southwest Environmental Engineering LLC by (signature) [Signature]

Send one white copy to Kansas Department of Health & Environment, Geology Section, 1000 SW Jackson Street, Ste. 420, Topeka, KS 66612-1367. Send one copy to WATER WELL OWNER and retain one for your records.
 Visit us at <http://www.kdheks.gov/waterwell/index.html> Telephone 785-296-5524.