

CORRECTION(S) TO WATER WELL RECORD (WWC-5)
(to rectify lacking or incorrect information)

Location listed as:

Section-Township-Range: 20-35-5W

Fraction (¼ ¼ ¼): NE NE NE

County: Republic
Location changed to:

20-35-5W

NE NE NE

Other changes: Initial statements: _____

Changed to: _____

Comments: _____


verification method: Written & legal descriptions, original construction records for these wells, position on plat map, and mapping tool on KGS website. initials: DRP date: 6/30/2006

submitted by: Kansas Geological Survey, Data Resources Library, 1930 Constant Ave., Lawrence, KS 66047-3726
to: Kansas Dept of Health & Environment, Bureau of Water, 1000 SW Jackson, Suite 420, Topeka, KS 66612-1367.

1 LOCATION OF WATER WELL: Fraction	Section Number	Township Number	Range Number
County: Republic NE 1/4 NE 1/4 NE 1/4	20	35	5W

Distance and direction from nearest town or city street address of well if located within city?
Chase Service, Liberty & Main, Courtland, KS

2 WATER WELL OWNER: **City of Courtland**
 RR#, St. Address, Box # **C/O Tim Gorman, Mayor** Board of Agriculture, Division of Water Resources
 City, State, ZIP Code : **Courtland, KS** Application Number:

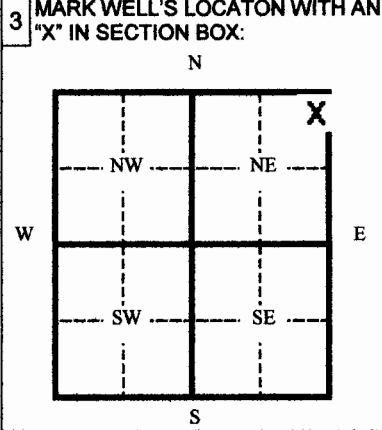

4 DEPTH OF WELL **25.62** ft.
 WELL'S STATIC WATER LEVEL **NA** ft.
 WELL WAS USED AS:
 1 Domestic 5 Public Water Supply 9 Dewatering
 2 Irrigation 6 Oil Field Water Supply 10 **Monitoring Well**
 3 Feedlot 7 Lawn and Garden (domestic) 11 Injection Well
 4 Industrial 8 Air Conditioning 12 Other _____
 Was a chemical/bacteriological sample submitted to Department? Yes ___ No **X**
 If yes, mo/day/yr sample was submitted _____
 Water Well Disinfected: Yes ___ No **X**

5 TYPE OF BLANK CASING USED:
 1 Steel 3 RMP (SR) 5 Wrought 7 Fiberglass 9 Other (specify below)
 2 **PVC** 4 ABC 6 Asbestos-Cement 8 Concrete Tile
 Blank casing diameter **2** in. Was casing pulled? Yes **X** No ___ If yes, how much **Overdrilled 25 FT**
 Casing height above or below land surface **0** in.

6 GROUT PLUG MATERIAL: 1 Neat cement 2 Cement grout 3 Bentonite 4 Other _____
 Grout Plug Intervals From **2** ft. to **25** ft. From _____ ft. to _____ ft. From _____ ft. to _____ ft.
 What is the nearest source of possible contamination:
 1 Septic tank 6 Seepage pit 11 Fuel storage 16 Other (specify below)
 2 Sewer lines 7 Pit privy 12 Fertilizer storage **None**
 3 Watertight sewer lines 8 Sewage lagoon 13 Insecticide storage
 4 Lateral lines 9 Feedyard 14 Abandoned water well
 5 Cess Pool 10 Livestock pens 15 Oil well/ Gas well

Direction from well? _____ How many feet? _____

FROM	TO	CODE	PLUGGING MATERIALS
25	2		Bentonite
2	0		Overburdened Soil

7 CONTRACTOR'S OR LANDOWNER'S CERTIFICATION: This water well was plugged under my jurisdiction and was completed on (mo/day/yr) **4/26/06** and this record is true to the best of my knowledge and belief. Kansas Water Well Contractor's License No. **554** This Water Well Record was completed on (mo/day/yr) **6/19/06** under the business name of **Woofter Pump & Well**
 by (signature) _____

INSTRUCTIONS: Please fill in blanks and circle the correct answers. Send three copies to Kansas Department of Health and Environment, Bureau of Water, 1000 S W Jackson St., Ste. 420, Topeka, Kansas 66620-0001. Telephone: 785-296-3565. Send one to Water Well Owner and retain one for your records.