

**CORRECTION(S) TO WATER WELL RECORD (WWC-5)**

(to rectify lacking or incorrect information)

County: Republic

Location listed as:

Location changed to:

Section-Township-Range: 20-35-5W

20-3S-5W

Fraction ( 1/4 1/4 1/4): NE NE NE

NE NE NE

Other changes: Initial statements: \_\_\_\_\_

Changed to: \_\_\_\_\_


Comments: \_\_\_\_\_

verification method: Written & legal descriptions, original construction records for these wells, position on plat map, and mapping tool on KGS website. initials: DRB date: 6/30/2006

1 LOCATION OF WATER WELL:	Fraction	Section Number	Township Number	Range Number
County: <b>Republic</b>	<b>NE ¼ NE ¼ NE ¼</b>	<b>20</b>	<b>35</b>	<b>5W</b>

Distance and direction from nearest town or city street address of well if located within city?  
**Chase Service, Liberty & Main, Courtland, KS**

2 WATER WELL OWNER: <b>City of Courtland</b>	Board of Agriculture, Division of Water Resources Application Number:
RR#, St. Address, Box # <b>C/O Tim Gorman, Mayor</b>	
City, State, ZIP Code : <b>Courtland, KS</b>	

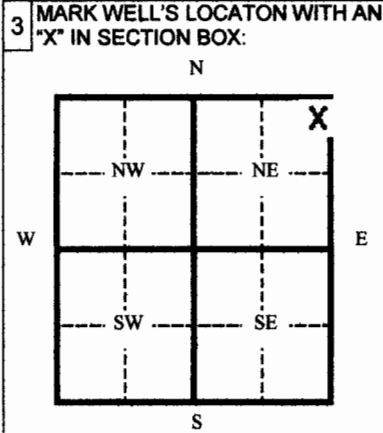

4	DEPTH OF WELL	<b>22.89</b>	ft.	
	WELL'S STATIC WATER LEVEL	<b>no</b>	ft.	
	WELL WAS USED AS:			
	1 Domestic	5 Public Water Supply	9 Dewatering	
	2 Irrigation	6 Oil Field Water Supply	<input checked="" type="radio"/> 10 Monitoring Well	
	3 Feedlot	7 Lawn and Garden (domestic)	11 Injection Well	
	4 Industrial	8 Air Conditioning	12 Other	
	Was a chemical/bacteriological sample submitted to Department?			Yes ___ No <input checked="" type="checkbox"/> x
	If yes, mo/day/yr sample was submitted			_____
	Water Well Disinfected:			Yes ___ No <input checked="" type="checkbox"/> x

5 TYPE OF BLANK CASING USED:

1 Steel	3 RMP (SR)	5 Wrought	7 Fiberglass	9 Other (specify below)
<input checked="" type="radio"/> 2 PVC	4 ABC	6 Asbestos-Cement	8 Concrete Tile	

Blank casing diameter **2** in. Was casing pulled? Yes  No \_\_\_ If yes, how much **Overdrilled 23 FT**

Casing height above or below land surface **0** in.

6 GROUT PLUG MATERIAL: 1 Neat cement 2 Cement grout 3 Bentonite 4 Other

Grout Plug Intervals From **2** ft. to **23** ft. From \_\_\_ ft. to \_\_\_ ft. From \_\_\_ ft. to \_\_\_ ft.

What is the nearest source of possible contamination:

1 Septic tank	6 Seepage pit	11 Fuel storage	16 Other (specify below)
2 Sewer lines	7 Pit privy	12 Fertilizer storage	<b>None</b>
3 Watertight sewer lines	8 Sewage lagoon	13 Insecticide storage	
4 Lateral lines	9 Feedyard	14 Abandoned water well	
5 Cess Pool	10 Livestock pens	15 Oil well/ Gas well	

Direction from well? \_\_\_\_\_ How many feet? \_\_\_\_\_

FROM	TO	CODE	PLUGGING MATERIALS
<b>23</b>	<b>2</b>		<b>Bentonite</b>
<b>2</b>	<b>0</b>		<b>Overburdened Soil</b>

7 CONTRACTOR'S OR LANDOWNER'S CERTIFICATION: This water well was plugged under my jurisdiction and was completed on (mo/day/yr) **4/26/06** and this record is true to the best of my knowledge and belief. Kansas Water Well Contractor's License No. **554** This Water Well Record was completed on (mo/day/yr) **6/19/06** under the business name of **Woofter Pump & Well**

by (signature) \_\_\_\_\_ *Angela Woofter*

INSTRUCTIONS: Please fill in blanks and circle the correct answers. Send three copies to Kansas Department of Health and Environment, Bureau of Water, 1000 S W Jackson St., Ste. 420, Topeka, Kansas 66620-0001. Telephone: 785-296-3565. Send one to Water Well Owner and retain one for your records.